

7.6.10.2


Department of Lands
 RECONNAISSANCE and MAINTENANCE REPORT

Integrative Survey of N.S.W

Note: Cross out word or words which do not apply

STATION TS 10731 FARRELLS [P]
 Co: DURHAM Ph: RAVENSWORTH
 Map Sheet: CAMBERWELL No: 9193-III-S
 Inspected by: P. McBEATH Date: 5-1-81
 Authority: I.S.B. NEWCASTLE Field Book: PDP 1608/3

Beacon Diagram Not to Scale

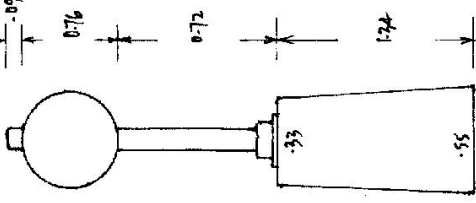

Date	Record of Station

This Trig. Station has been:

1. Completely cleared to permit 360° vision to surrounding Trigs.
2. Cleared by lanes bearing 90 M - 0 M from Trig. Mast
3. Trig. Mast & Vanes have been painted white & black respectively. /
4. The Trig. was unpiled/not unpiled, dimensions now being: NEW STATION
 Description of mark: CONCRETE PILLAR should be explicit, e.g. Steel plug, Brass plug, Bolt, Concrete Pillar
 Height of mark: 1.34 m above rock/concrete 1.34 m above G.L.
 Height of Top Vanes to Top Mark/Top pillar plate: 1.48 m Diameter of Vanes (vertical) 0.76 m.
 Height of Pillar: 1.34 m. Diameter of ~~Center~~ Pillar: 35 x 55 m.
 Length of Mast: 1.57 m. (approximate if not unpiled)

5. A. S.M. 37405 set in conc./rock has been placed/td 14.455 m bearing 247° 0M from Trig. Mast/pillar
6. A. C.S. set in conc./soil has been placed/td 11.300 m bearing 2.00° 0M from Trig. Mast/pillar
7. A. set in conc./soil has been placed/td m bearing °M from Trig. Mast/pillar
8. A. set in conc./rock has been placed/td m bearing °M from Trig. Mast/pillar
9. Connection: S.M. 37405 C.S. 10.123 m bearing 117° 0M
10. Connection: to m bearing °M
11. Connection: to m bearing °M
12. Connection: to m bearing °M
13. Diff. Ht. Pillar plate is 2.137 m above S.M. 37405
 below
14. Diff. Ht. Pillar plate is 1.875 m above C.S.
 below
15. Diff. Ht. S.M. 37405 is 0.267 m above C.S.
 below
16. Diff. Ht. is m above
 below

Prepared by: P. McBEATH Checked: [Signature]

STATION TS 10731 FARRELLS (P)

Owners Name: Coal & Allied Plc
 Current Occupant:
 Address: NEWCASTLE
 Address:

Access 5.1-1981 FROM SINGLETON.
 00 kms Int'n. New England Hwy & road to Lemington (approx 1/2 kms south of Ravensworth).
 2.7 Wooden bridge
 4.45 Pass entrance to Hunter Valley N1 Colliery on right.
 5.85 Turn right through 2 iron gates. Follow faint track south.
 6.85 T.S.

2 Wheel drive access all weather.

