

25-103

Department of Lands

Integral Survey of N.S.W. RECONNAISSANCE and MAINTENANCE REPORT

STATION TS 10734 THE CHANNON

This Trig. Station has been: Co: ROUS

Note: Cross out word or words which do not apply

PH: NIMBIN

Map Sheet: DUNLOON 1 155000 355000 1-5 No:

1. Completely cleared to permit 360° vision to surrounding Trigs.

Date: 4th Sept. 1973

Inspected by: L.H. Anderson

2. Cleared by lances bearing

Authority: Integration Survey Branch, L. Field Book, Misc.

Beacon Diagram: Trig. Reserve E0314

3. Trig. Mast & Vanes have been painted white & black respectively.

Not to Scale

Height of mark: Steel spikes (60 cm long)

4. The Trig. was ~~upplied~~ not upplied, dimensions now being: NEW TRIG.

NO BRASS

Description of mark: Steel spikes (60 cm long) should be explicit, e.g. Steel plug, Brass plug, Bolt, Concrete Pillar

Height of mark: ~~steel concrete~~ m above below G.L.

Height of Top Vanes to Top Mark/Top pillar plate: m Diameter of Vanes (vertical): m.

Height of Cairn: m Diameter of Cairn: m.

Length of Mast: m (approximate if not upplied)

5. A set in conc./rock has been placed/rd m. bearing m from Trig. Mast/pillar

6. A set in conc./soil has been placed/rd m. bearing m from Trig. Mast/pillar

7. A set in conc./soil has been placed/rd m. bearing m from Trig. Mast/pillar

8. A set in conc./rock has been placed/rd m. bearing m from Trig. Mast/pillar

9. Connection to m. bearing m

10. Connection to m. bearing m

11. Connection to m. bearing m

12. Connection to m. bearing m

13. Diff. Ht. is m above below

14. Diff. Ht. is m above below

15. Diff. Ht. is m above below

16. Diff. Ht. is m above below

Prepared by: D. VINCENT

Checked: 40


Date: Record of Station

STATION TS 10734

Owners Name CROWN Current Occupant


Address Y.R. 50314 Address

Access DUNOON 1:25000 Map 4-9-1979

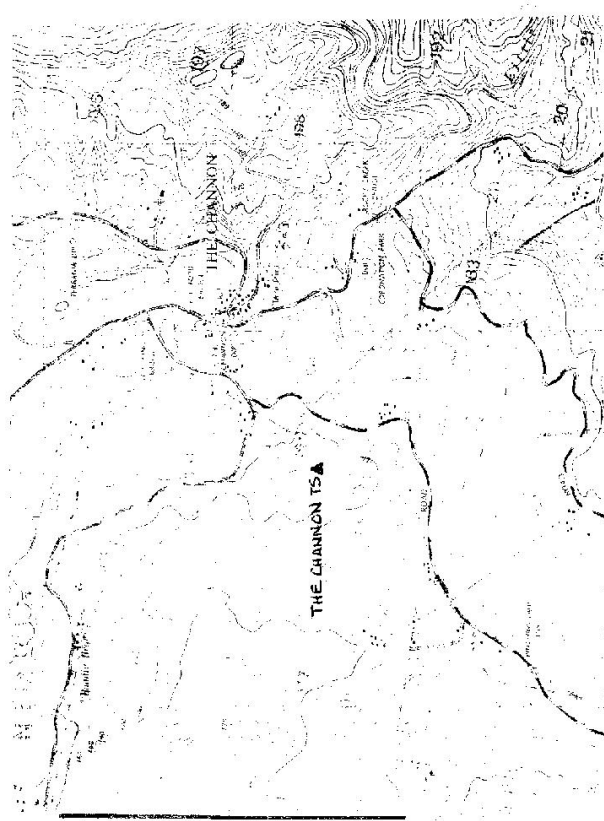

D. West, Government Printer, New South Wales - 1976

Station Diagram Not to Scale

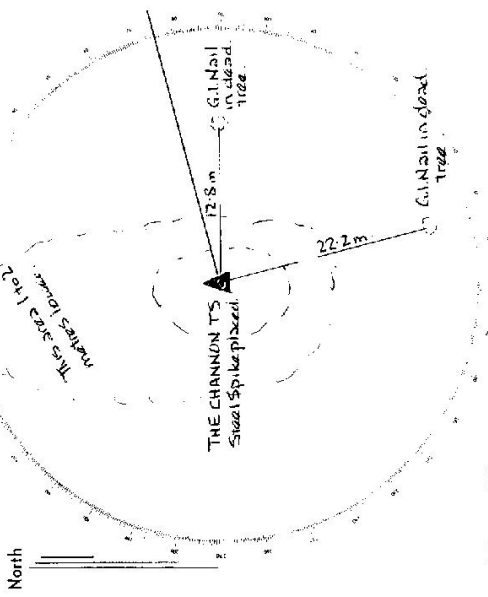

List of Observed Directions:-

Standpoint: Steel Spike		Standpoint:	
Station	Direction	Station	Direction
DUNOON TS	0° 00' 00"		
GINAIL in dead tree	14° 08'		
GINAIL in dead tree	50° 54'		
Station	Direction	Station	Direction