

75 10

Department of Lands

RECONNAISSANCE and MAINTENANCE REPORT

Integra Survey of N.S.W.

STATION BLUE FISH (P) TS 10739

This Trig. Station has been:-

Note: Cross out word or words which do not apply

Co: COMBERLAND
 Ph: MAINLY CONE
 Map Sheet: NORTH HEAD 1: 10000
 No: UZ752
 Inspected by: F. SMITH
 Date: 4/81
 Authority: MWS & DA
 Field Book: -
 Beacon Diagram: Not to Scale


1. Completely cleared to permit 360° vision to surrounding Trigs.
2. Cleared by lanes bearing..... from Trig. Mast
3. Trig. ~~Mast & Vanes have been painted white & black~~ respectively.
4. The Trig. was unpiled/not unpiled, dimensions now being: NEW PILLAR

Description of mark: STEEL PILLAR..... should be explicit, e.g. Steel plug, Brass plug, Bolt, Concrete Pillar
 Height of mark..... m ^{above} ~~rock~~ concrete ^{above} G.L.
 Height of Top Vanes to Top Mark/Top pillar plate..... m Diameter of Vanes (vertical)..... m.
 Height of Cairn..... m. Diameter of Cairn..... m.

- Length of Mast..... m. (approximate if not unpiled)
 Pouch Mark in
 5. ~~As steel~~ ~~mark~~ set in conc/~~rock~~ has been placed ~~at~~ 2.790 m. bearing 185° 36' 30" ~~NS~~ from ~~Trig. Mast~~ pillar
 6. ~~A lead plug~~ set in conc/~~soil~~ has been placed ~~at~~ 5.184 m. bearing 294° 29' ~~NS~~ from ~~Trig. Mast~~ pillar
 7. A..... set in conc/soil has been placed ~~at~~..... m. bearing.....°M from Trig. Mast/pillar
 8. A..... set in conc/rock has been placed ~~at~~..... m. bearing.....°M from Trig. Mast/pillar

9. Connection: ~~Pillar~~ to ~~Steel Pillar~~ : ~~257.340~~ m. bearing ~~185° 50' 00" NS~~
~~Satellite~~
 10. Connection:..... to..... m. bearing.....°M
 11. Connection: ~~Pillar~~ to ~~SMA 9517~~ : ~~2.721~~ m. bearing ~~185° 50' 00" NS~~ (Cook)
~~GRAD~~
 12. Connection:..... to..... m. bearing.....°M
 13. Diff. Ht. m. ^{above} below
 14. Diff. Ht. m. ^{above} below
 15. Diff. Ht. m. ^{above} below
 16. Diff. Ht. m. ^{above} below

Prepared by: T.S. Checked: MACT

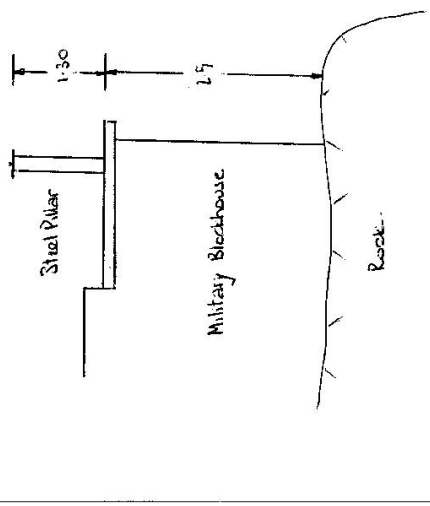

Date	Record of Station
4-81	Pillar Checked F. J. Smith (MWS & DA)

STATION BLUE FISH [P] TS 10739


Owners Name.....

Address.....

Access 2 WD from Manly
4/1981

AT NORTH HEAD

TASMAN

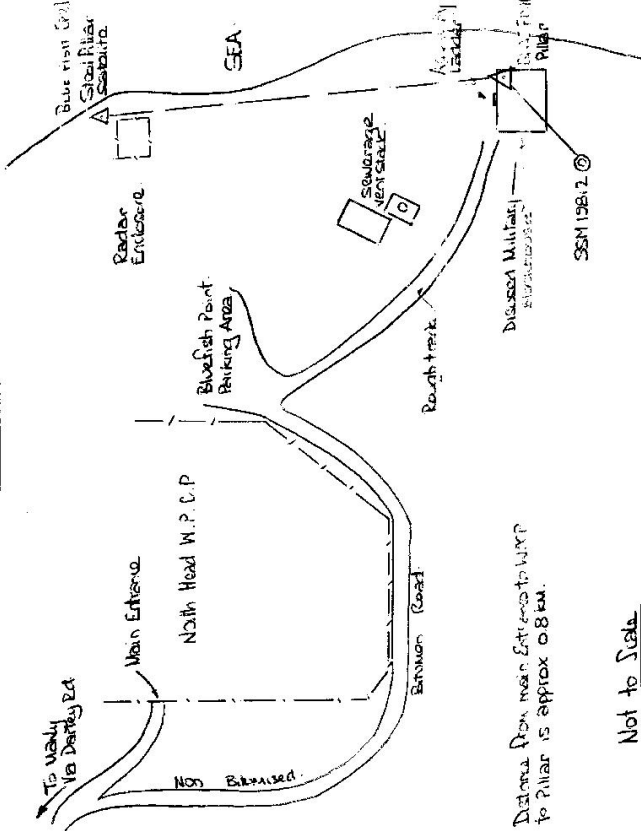


D. West, Government Printer, New South Wales - 1976

Not to Scale

Not to Scale

Station Diagram
ISG North

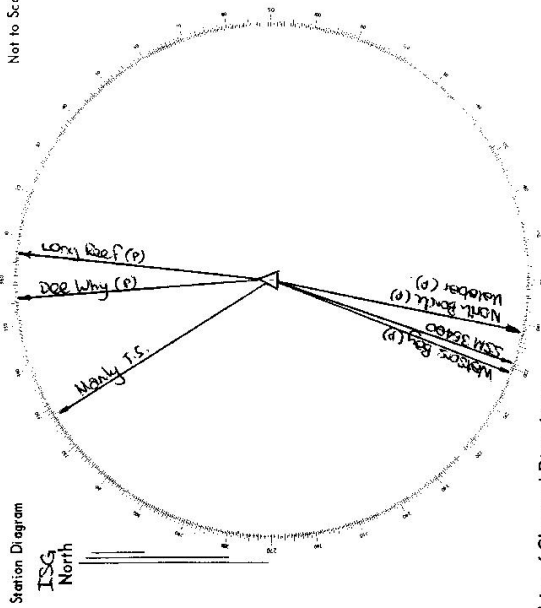

List of Observed Directions:-

Station	Direction	Station	Direction
Standpoint: Blue Fish [P]			
SSM 35400	0° 00' 00"	Long Reef (P)	167° 51' 20" E
Wetsons Bay (P)	2° 58' 41" E	North Head Substation	347° 00' 19"
Manly T.S.	157° 59' 36" E		
Doe Why (P)	157° 23' 32"		
Standpoint: Blue Fish [P] ~ 4 Sets Wind Tz			
North Beach (P)	0° 00' 00"	Manly T.S.	126° 11' 25" E
Manly (P)	359° 46' 01" E	Long Reef (P)	174° 03' 01" E
SSM 35400	6° 11' 46"		
Wetsons Bay (P)	9° 05' 36" E		