

7.5.19.3

Department of Lands Integral Survey of N.S.W.
RECONNAISSANCE and MAINTENANCE REPORT

STATION CAPE BANKS [P] TS 10741
 Co: Cum gratia land | Ph: Botany
 Map Sheet: KURNELL No: U 1030
 Inspected by: F SMITH, P HARKLAW Date: 4/8/81
 Authority: M.L.S.D.B. INTERSECTION Field Book: 1751/8
 Beacon Diagram Not to Scale

Note: Cross out word or words which do not apply

This Trig. Station has been:-

1. Completely cleared to permit 360° vision to surrounding Trigs.
2. Cleared by lanes bearing..... from Trig. Mast
3. Trig. Mast & Vanes have been painted ~~white & black~~ respectively.
4. The Trig. was unpiled/not unpiled, dimensions now being: **NEW PILLAR**

Description of mark..... **Steel Pillar** should be explicit, e.g. Steel plug, Brass plug, Bolt, Concrete Pillar

Height of mark..... 2.64 m above ~~rock~~ **concrete** m above ~~below~~ G.L.

Height of Top Vanes to Top Mark/Top pillar plate m Diameter of Vanes (vertical)..... m.

Height of Cairn m. Diameter of Cairn..... m.

Length of Mast..... m. (approximate if not unpiled)

5. A ~~Lead~~ **Plug** set in ~~conc/rock~~ has been placed 44.56 m. bearing 308.37.10.185 from Trig. Mast/pillar (w.B)

6. A set in conc./soil has been placed fd m. bearing °M from Trig. Mast/pillar

7. A set in conc./soil has been placed fd m. bearing °M from Trig. Mast/pillar

8. A ~~B.M.S.P.~~ **Plug** set in ~~conc/rock~~ has been placed 44.62 m. bearing 231.08.10.185 from Trig. Mast/pillar (w.B)

9. Connection ~~Pillar~~ to ~~S.M.S.P.~~ **GRAD** m. bearing 194.34.23.185 (w.B)

10. Connection **PILLAR** to ~~S.M.S.P.~~ **GRAD** m. bearing 163.18.185 °M

11. Connection to m. bearing °M

12. Connection to m. bearing °M


13. Diff. Ht. ~~PAVES~~ **PIERS** is 10.18 m. above ~~below~~ **S.M.S.P. (TS 915)**

14. Diff. Ht. is m. above below

15. Diff. Ht. is m. above below

16. Diff. Ht. is m. above below

Prepared by: W.S.H. Checked: P.R.H.

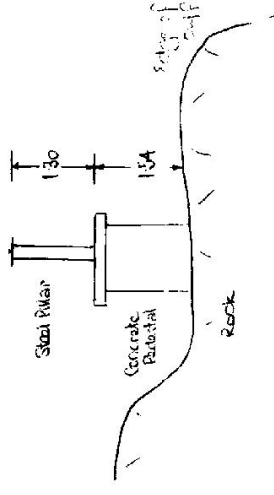

Date	Record of Station
4.81	Pillar Erected F.J. Smith (M.W.S. & D.B.)
7.81	Station Visited M. Farrell


STATION TS CAPE BANKS [D] TS10741

Owners Name.....
 Current Occupant.....

Address.....
 Address.....


Access 2 W.D. 4 / 1981

Station Diagram
 ISG North
 Not to Scale

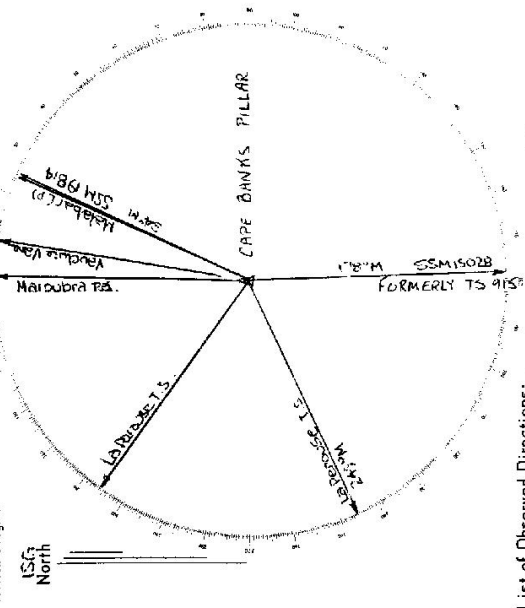

List of Observed Directions:-
 Standpoint: CAPE BANKS PILLAR
 Station: CAPE BANKS PILLAR FB. 15.16

Station	Direction	Station	Direction
LA PERRAISE T.S.	0° 00' 00"	SSM 19228 T.S. 9157	208° 47' 56.2
MARDOBRA Pt.	54° 56' 00" S	T.S. LA PERRAISE	316° 28' 55.4
MARDOBRA Pt.	62° 03' 48.2	T.S. MARDOBRA	34° 00' 00.0
SSM 19814	78° 11' 44"		

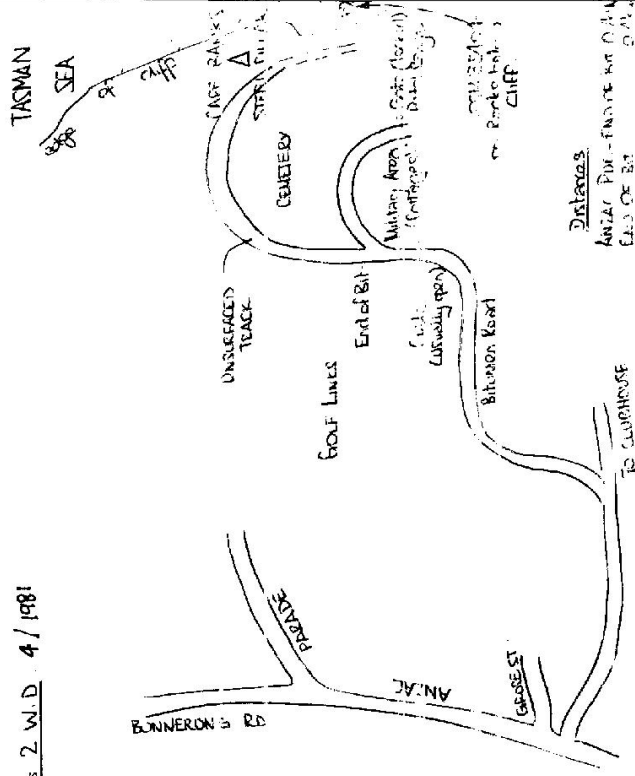

Not to Scale

D. West, Government Printer, New South Wales 1976