


STATION WAVERLE RES (P) 1579D

Co: Cumberland
Map Sheet: SYDNEY
No: U18AS
Inspected by: F. SMITH
Date: 4/81
Authority M.W.S. & D.B.
Field Book: -

Beacon Diagram
Net to Scale

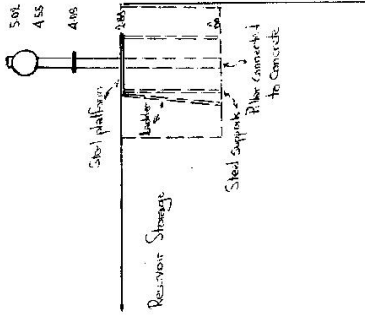

RECONNAISSANCE and MAINTENANCE REPORT

Note: Cross out word or words which do not apply

This Trig. Station has been:-

1. Completely cleared to permit 360° vision to surrounding Trigs.
2. Cleared by limes bearing..... from Trig. Mast
3. Trig. Mast & Vanes have been painted white & black respectively.
4. The Trig. was unpiled/not unpiled, dimensions ~~no.~~ being: **NEW PILLAR**
~~Original Mast~~ ~~Mark found~~
Description of mark: ~~Steel Pillar & Vanes~~ should be explicit, e.g. Steel plug, Brass plug, Bolt, G.I. Pipe
Height of mark: ~~1.2~~ m ^{above} ~~below~~ **rock/concrete steel** 4.08 m ^{above} ~~below~~ **concrete**
Height of Top Vanes to Top Mark: **0.94** m. Diameter of Vanes (vertical) **0.17** m.

Height of Cairn..... m. Diameter of Cairn..... m.

Length of Mast..... m. (approximate if not unpiled)

5. A..... set in conc./rock has been placed..... m. bearing..... M from Trig. Mast

6. A..... set in conc./soil has been placed..... m. bearing..... M from Trig. Mast

7. A..... set in conc./soil has been placed..... m. bearing..... M from Trig. Mast

8. A..... set in conc./rock has been placed..... m. bearing..... M from Trig. Mast

9. Connection **Pillar to Mast** ~~to~~..... m. bearing ~~SS on 86.0°E~~ **ISG**

10. Connection..... to..... m. bearing..... M

11. Connection..... to..... m. bearing..... M

12. Connection..... to..... m. bearing..... M

13. Diff. Ht. is..... m. ^{above} ~~below~~

14. Diff. Ht. is..... m. ^{above} ~~below~~

15. Diff. Ht. is..... m. ^{above} ~~below~~

16. Diff. Ht. is..... m. ^{above} ~~below~~

Prepared by: **CS**

Checked: **WJ**

Noted on U.T.M. Card

Date

Record of Station

Checked


STATION WAWERLEY RES(P)TS 10742

Owners Name.....
 Current Occupant.....
 Address.....
 Address.....

Access 2 W/D 4/1981

Not to Scale

Station Diagram
 I.S.C.
 North

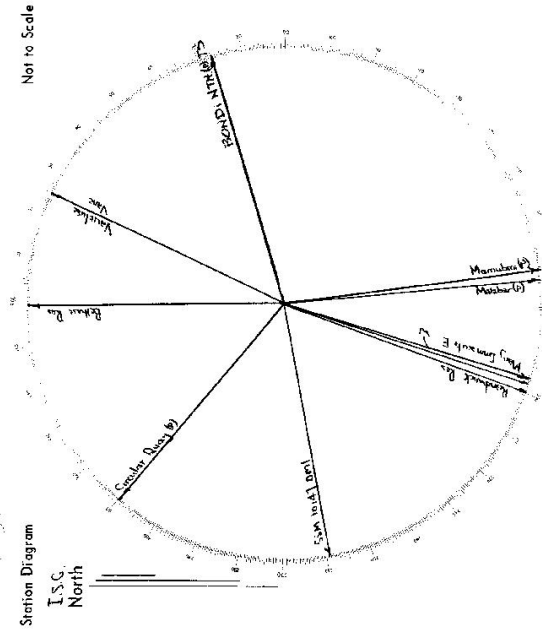

List of Observed Directions:-

Station	Direction	Station	Direction
Crescent Quay (P)	5 05 00	Marrubidge (P)	294 58 15.5
Bellvue Res	43 45 44.4	Mary Immaculate East	046 44 33
Nucleus None	75 19 11.2	Mary Immaculate West	041 41 18.8
BEND NORTH (P)	123 40 41.5	Marrubidge Reserve	049 10 44.1
Marrubidge (P)	202 34 31.2	SSM 101A1 DM1	305 27 16.1

