

CENTRAL MAPPING AUTHORITY


GEODETIC SURVEY OF N.S.W.

GEODETIC STATION RECONNAISSANCE and MAINTENANCE REPORT

STATION: **ROCKTON PILLAR** No.: **10746**

- Description: **360° VIEW** *Note: Cross out word or words which do not apply*
- Cleared by lanes bearing **360°**..... from Trig, Mast
 - Mast & Vanes have been painted white & black respectively. **NEW PILLAR # BEACON**
 - The station/pillar was **replaced/retamped/constructed on** **7/5/1980**, dimensions now being:
 Description of mark..... should be explicit, e.g., S/Steel Pillar Plate, Steel plug, Brass plug, Bolt, G.I. Pipe
 Height of mark..... **1.35** ^{above} ~~below~~ **feet/concrete**; Mark is **1.4** ^{above} ~~below~~ **G.L.**
 Height of Top Vanes to Top Mark/Pillar plate **1.45**.....m. Diameter of Vanes (vertical)..... **0.60**.....m.
 Height of Cairn.....m. Diameter of Cairn.....m. Name Plate found/not found/placed.
 Length of Mast **1.54**.....m. (approximate if not unpled)
 - A. G.I.P.**..... set in conc/rock has been placed/found, bearing..... **14**.....°M from ~~Mast/Plug~~/Pillar
 - A. COPPER SPIKE**..... set in conc/rock has been placed/found, bearing..... **78**.....°M from Mast/Plug/Pillar
 - A.**..... set in conc/rock has been placed/found, bearing.....°M from Mast/Plug/Pillar
 - A.**..... set in conc/rock has been placed/found, bearing.....°M from Mast/Plug/Pillar
 - Action required:.....

MAP SHEET SCALE 1:250 000
 INSPECTED BY: **S. GREENING** DATE: **9.5.80**
 AUTHORITY: **D.M.R.** FIELD BOOK:

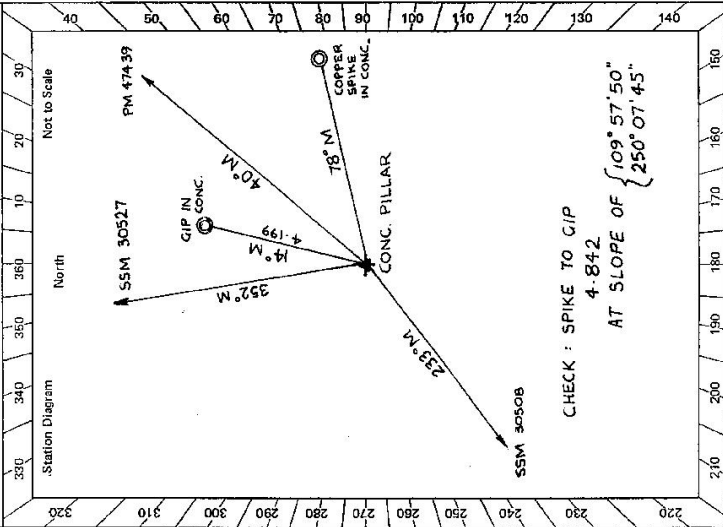

STANDPOINT: PILLAR				STANDPOINT: COPPER SPIKE			
Mark	Direction	Horiz. Distance	Height Difference	Mark	Direction	Horiz. Distance	Height Difference
SSM 30508	0° 00' 00"		above standpt	SSM 30527	0° 00' 00"		above standpt
GIP	141° 32'		below standpt	PM 474 39	47° 27' 14"		above standpt
PM 474 39	166° 29' 57"		below standpt	PILLAR	267° 47' 30"	4.250	above standpt
COPPER SPIKE	206° 46' 30"		below standpt	GIP	324° 37' 30"		below standpt
			above standpt				above standpt
			below standpt				below standpt

Prepared by: **S. GREENING** Checked: *[Signature]* Noted on U.T.M. Card

Checked

38

<p>STATION ROCKTON PILLAR TS 10746</p> <p>Owner's Name: Address: Phone:</p> <p>Current Occupant: Address: Phone:</p> <p><u>ACCESS</u> Access Report of <u>1.1.2.1980</u> was found suitable/unsuitable.</p>		<p>Date:</p> <p>Record of Station:</p>
<p>Beacon Diagram</p> <p style="text-align: right;">Not to Scale</p>	<p>This section to be completed by officer constructing pillar.</p> <p>Original beacon mark found/not found</p> <p>Description of mark:</p> <p>Original beacon found/not found:</p> <p>Description of beacon:</p> <p>Height Top of Vanes to Top Mark: <u>1.45</u>.....m.</p> <p>Height of mark: <u>1.35</u> m. above <u>0.05</u> m. below G.L.</p> <p>Diameter of Vanes <u>0.6</u>.....m. Height of Cairn <u>2.1</u>.....m.</p> <p>Original Beacon has/has not been destroyed by me.</p>	