

Department of Lands  
Integral Survey of N.S.W.  
RECONNAISSANCE and MAINTENANCE REPORT  
STATION BONDIA NORTH [P2] T.S. 10750

This Trig. Station has been:-  
1. Completely cleared to permit 360° vision to surrounding Trigs.  
2. Cleared by lanes bearing. from Trig. Mast  
3. Trig. Mast & Vanes have been painted white & black respectively.  
4. The Trig. was unpiled/not unpiled, dimensions now being:

Description of mark: STEEL PILLAR should be explicit, e.g. Steel plug, Brass plug, Bal, Concrete Pillar  
Height of mark: m above rock, concrete m below G.L.  
Height of Top Vanes to Top Mark/Top pillar plate m Diameter of Vanes (vertical) m  
Height of Cairn m Diameter of Cairn m  
Length of Mast m (approximate if not unpiled)

5. A Lead Plug set in conc/rock has been placed 46 7.91 m. bearing 309° 28' 50" M from Trig. Mast/pillar  
6. A G.L. Nail set in conc/rock has been placed 44 5.04 m. bearing 198° 15' 00" M from Trig. Mast/pillar  
7. A set in conc/soil has been placed 4d m. bearing °M from Trig. Mast/pillar  
8. A set in conc/rock has been placed 4d m. bearing °M from Trig. Mast/pillar


9. Connection: Pillar to T.S. 10750: 335.924 m. bearing 65° 25' 01" M  
BONDIA NORTH(S)

10. Connection: to m. bearing °M  
11. Connection: to m. bearing °M  
12. Connection: to m. bearing °M

13. Diff. Ht. is m. above below  
14. Diff. Ht. is m. above below  
15. Diff. Ht. is m. above below  
16. Diff. Ht. is m. above below

Prepared by: WJL Checked: WJL

Note: Cross out word or words which do not apply  
Beacon Diagram  
Note: No mast or Vanes  
Not to Scale

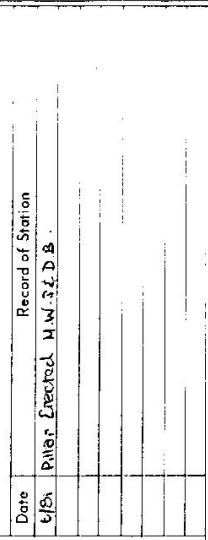

Date	Record of Station
1/5/19	Pillar Erected M.W.S.D.B.


Co: CLIMBERLAND Ph: ALEXANDRIA  
Map Sheet: SYDNEY 1 100000 No: L11845  
Inspected by: F. SMITH Date: July '81  
Authority: N.W.S. & D.B. Field Book:  
Beacon Diagram  
Note: No mast or Vanes  
Not to Scale

STATION BONDIA NORTH [02] TS 10750

Owners Name..... Current Occupant.....

Address..... Address.....


Access 2 W/D July 1981  
 NOTE: SEE NORTH BONDIA [P] FOR ACCESS DETAILS

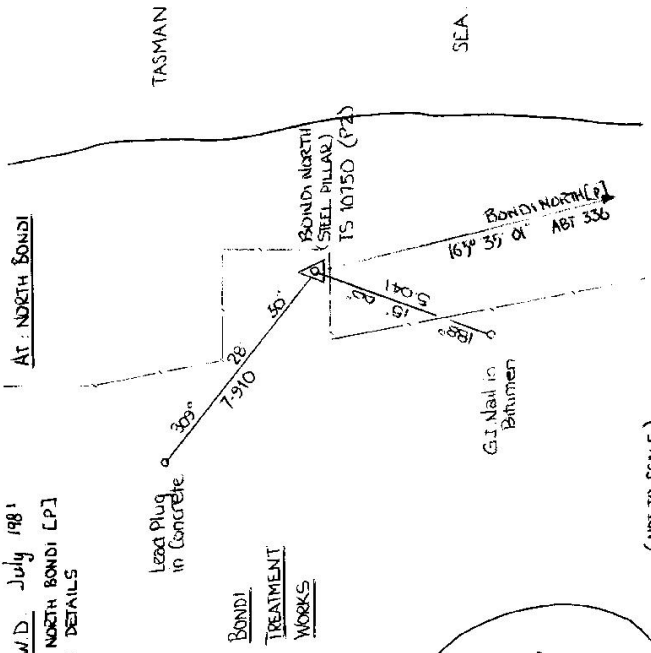

(NOT TO SCALE)

D. West, Government Printer, New South Wales - 1976

Station Diagram Not to Scale

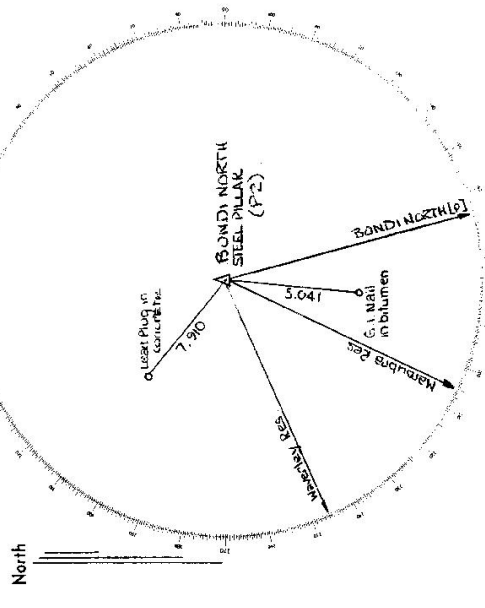

List of Observed Directions:-

Stationpoint: TS 10750		Station	Direction
BONDIA NORTH [P]	165° 35' 01"		
G.I. Nail in Bitumen	198° 45' 00"		
Mangrovia Res	205° 54' 01"		
Wentley Res	245° 21' 26"		
Lead Plug in Concrete	309° 28' 30"		
Station	Direction	Station	Direction