

75 102

Department of Lands  
 Integrat Survey of N.S.W.  
**10753 RECONNAISSANCE and MAINTENANCE REPORT**

STATION **TS WRIGHTS LANE (P) TS 10753**  
 Co: **Comberland** Ph: **Castle reach**


Map Sheet: **SPRINGWOOD** No: **9030-N-S**  
 Inspected by: **R. HAMMILL** Date: **28.1.1981**  
 Authority: **INTEGRATION SURVEYS BRANCH** Field Book: **PP 1736/2**

This Trig. Station has been:-  
 Note: Cross out word or words which do not apply

1. Completely cleared to permit 360° vision to surrounding Trigs.
2. ~~Cleared by fones-bearing~~ from Trig Mast
3. Trig. Mast & Vanes have been painted white & black respectively.
4. The Trig. ~~was supplied with~~ was dimensions now being:  
 Description of mark: Concrete Pillar should be explicit, e.g. Steel plug, Brass plug, Ball, Concrete Pillar  
 Height of mark: 1.36 m above rock concrete 1.36 m above G.L.  
 Height of Top Vanes to Top Mark Top pillar plate: 1.39 m Diameter of Vanes (vertical): 0.60 m.  
 Height of Centre: m Diameter of Centre: m

5. ~~A set in conc/rock has been placed/rd~~ m bearing m from Trig. Mast/pillar
6. ~~A set in conc/soil has been placed/rd~~ m bearing m from Trig. Mast/pillar
7. ~~A set in conc/soil has been placed/rd~~ m bearing m from Trig. Mast/pillar
8. ~~A set in conc/rock has been placed/rd~~ m bearing m from Trig. Mast/pillar
9. Connection: to m bearing m
10. Connection: to m bearing m
11. Connection: to m bearing m
12. Connection: to m bearing m
13. Diff. Ht. is m above below
14. Diff. Ht. is m above below
15. Diff. Ht. is m above below
16. Diff. Ht. is m above below

Prepared by: R. Ham 15.10.81 Checked:

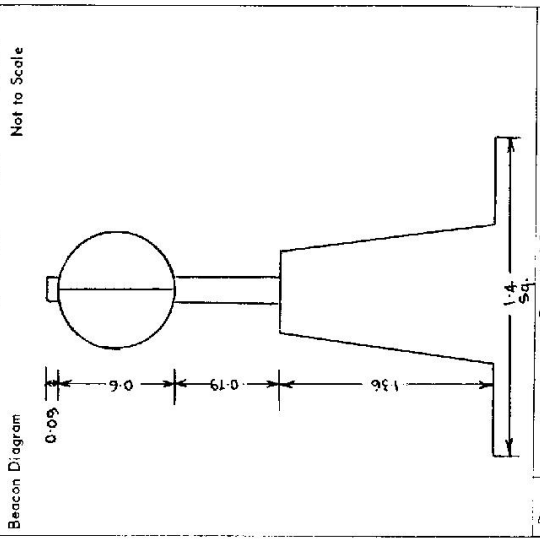


Date: 28.1.81  
 Record of Station  
 Pillar Erected: R. Hammill

STATION TS. WRIGHTS LANE (P)

Owners Name: PEARITH LAMES DEVELOPMENT CORP P/L  
 Address: 300 INVERMUE BUILDING 2ND FLOOR 5105 HIGH STREET, PEARITH 7150 PHONE: (082) 37 2700  
 Current Occupant: SEE DIVISION  
 Address: \_\_\_\_\_

Access 28-1-1981

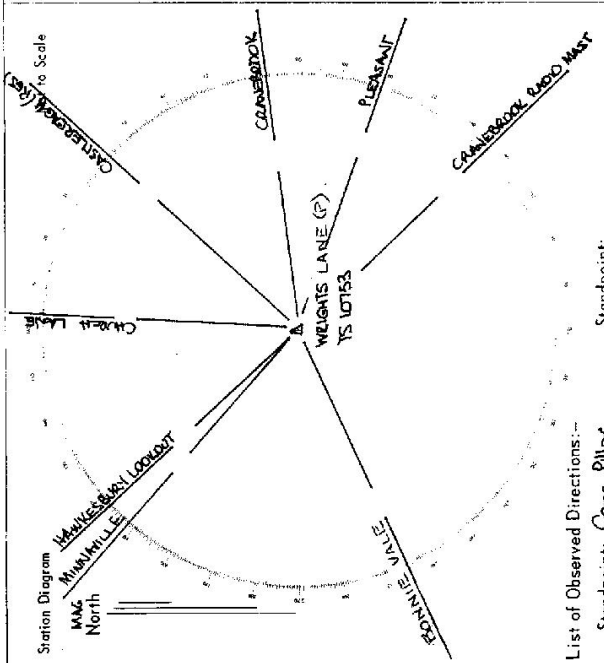

List of Observed Directions:-

Station	Direction	Station	Direction
WAINWRIGHTS LOOKOUT [P]	371 09 00	CAMBRIDGE RADIO MAST [P]	196 40 06
CHURCH LANE [P]	1 07 43	MUNNAHILLE [P]	205 21 46
CASTLEBANK RES	44 37 18		371 16 54
CAMBRIDGE [P]	83 21 56		
PLEASANT [P]	109 06 30		

Standpoint: Come Piller

Station	Direction	Station	Direction

