




TS 10754 STATION CRANE BROOK (P)

Owners Name... PENRITH LAKES DEVELOPMENT COOP'S P/L  
 Address... 280 INSURANCE BUILDING 3RD FLOOR 535 HIGH ST PENRITH 2150 PHONE (000) 322700

Current Occupant... SAME AS OWNER


Address

Access 28-1-1981

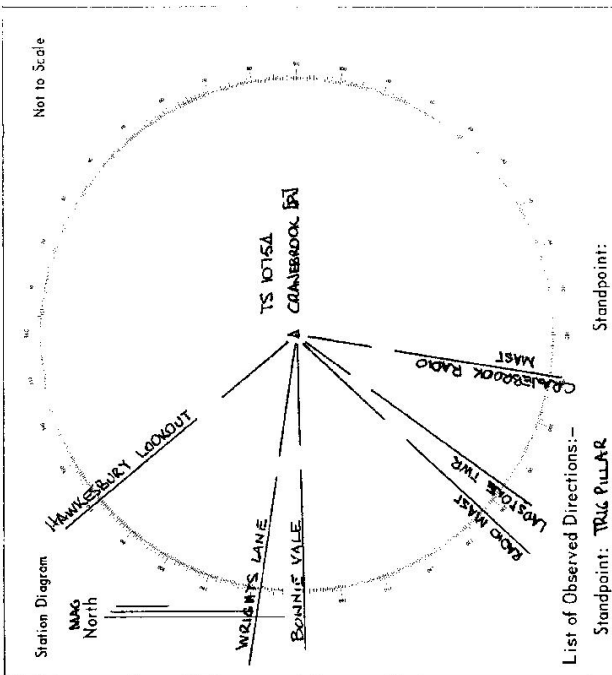

List of Observed Directions:-

Standpoint: TRIG PILLAR		Standpoint: 00M <sup>2</sup>	
Station	Direction	Station	Direction
HAWKESBURY LOOKOUT [P]	310 00 00.0	WRIMMS LANE (P)	178 47 39
CRANE BROOK RADIO MAST	189 07 57		
LANTIERE TOWER	116 46 46		
RADIO MAST	233 11 07		
BONNIE VALE [P]	260 11 30		

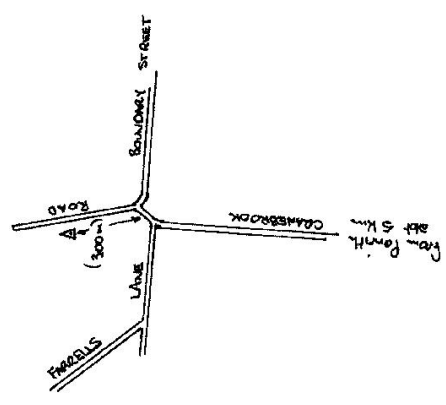

D. West, Government Printer, New South Wales - 1976