


STATION UPPER CASTLEREAGH (P)

TS 10755

Owners Name... UNITING CHURCH
 Address... CASTLEREAGH ROAD, UPPER CASTLEREAGH

Current Occupant... See Owner
 Address... See Owner

Access 29-1-1981

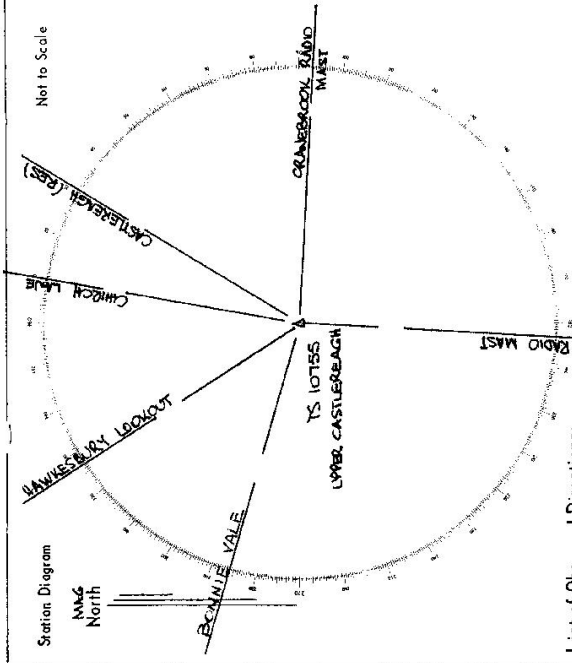

List of Observed Directions:-

Station		Direction		Station		Direction	
Station	Count	Direction	Station	Count	Direction	Station	Count
WARRIBROOK LOOKOUT [P]	317	02	20	EDONNIE VALE [P]	286	20	39
CHURCH LANE [P]	10	40	47				
CASTLEREAGH (LES)	31	00	00				
CRANEBOOK RADIO MAST	93	43	12				
RADIO MAST	180	32	11				

