

74-103

Department of Lands Integration, survey of N.S.W. RECONNAISSANCE and MAINTENANCE REPORT

This Trig. Station has been:

Note: Cross out word or words which do not apply

1. Completely cleared to permit 360° vision to surrounding Trigs.
2. Cleared by lanes bearing..... from Trig. Mast
3. Trig. Mast & Vanes have been painted white & black respectively. ✓
4. The Trig. was unpiled/not unpiled, dimensions now being:
 - Description of mark..... S/S Pillar. 8 LATHA should be explicit, e.g. Steel plug, Brass plug, Bolt, Concrete Pillar
 - Height of mark..... 1.360 m above below ~~feet~~ concrete SLAB 1.490 m above G.L.
 - Height of Top Vanes to Top Mast/Top pillar plate..... 4.43 m Diameter of Vanes (vertical) 0.597 m.
 - Height of Cairn..... m. Diameter of Cairn..... m.

5. A ~~6.680~~ m. set in conc./rock has been placed/44 4.255 m. bearing..... 86° M from Trig-Mast/pillar
6. A ~~6.114~~ m. set in conc./soil has been placed/44 4.738 m. bearing..... 332° M from Trig-Mast/pillar
7. A..... set in conc./soil has been placed/44..... m. bearing.....°M from Trig. Mast/pillar
8. A..... set in conc./rock has been placed/44..... m. bearing.....°M from Trig. Mast/pillar
9. Connection. C.N. to Cairn..... : 9.070 m. bearing..... 307° M
10. Connection..... to..... :..... m. bearing.....°M
11. Connection..... to..... :..... m. bearing.....°M
12. Connection..... to..... :..... m. bearing.....°M
13. Diff. Ht. is..... m. above below
14. Diff. Ht. is..... m. above below
15. Diff. Ht. is..... m. above below
16. Diff. Ht. is..... m. above below

Prepared by: W. M. CILLIVRAY Checked: RBG


Station TS 10760	PEKO (P)
Co: NORTHWATERBELLAIR	Ph: YEAL
Map Sheet: BELLAIR 1:25000	No: 9182-IV-5
Inspected by: W. M. CILLIVRAY	Date: 26-9-81
Authority: S.S.	Field Book:
Beacon Diagram	
Not to Scale	
Date: 26-9-81	Record of Station: CONTINUED PAGE

STATION T.S. 10760 PLSKO (P)

Owners Name: PLSKO-WALLSAND Current Occupant:

Address: Address:

Access 26-9-1981
 D.O
 0-7 POST OFFICE SHELLETON HEAD TOWARDS WINDSOR
 8-7 RAILWAY CROSSING
 13-9 TURN LEFT SIGN WOODLAMB
 RING ON LEFT

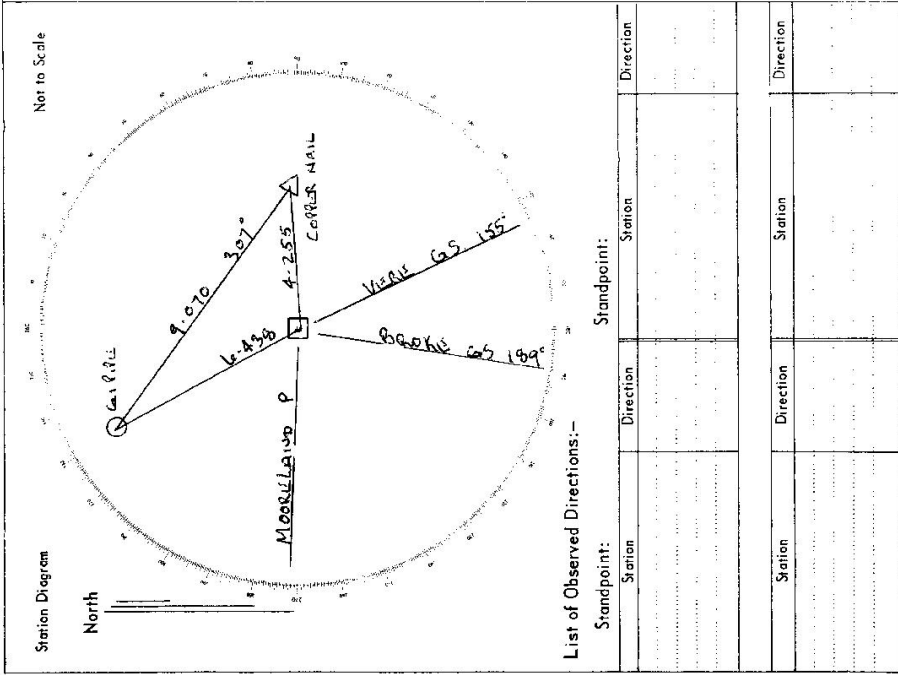

List of Observed Directions:-

Standpoint:		Station:	
Station	Direction	Station	Direction