

70 193

Department of Lands Integration Sur if N.S.W.
RECONNAISSANCE and MAINTENANCE REPORT

STATION T 5 10762 SPAINVILLE (P)
 Co: NORTHUMBERLAND Ph: VERE
 Map Sheet: BULLIOA 1 252647 No: 5932 10 5
 Inspected by: T Duffy Date: 21-10-21
 Authority: SURVEY GENERAL BRANCH Field Book: 1717/15


This Trig. Station has been:-
 Note: Cross out word or words which do not apply

1. Completely cleared to permit 360° vision to surrounding Trigs.
2. ~~Cleared by~~ **limes-bearing** from Trig. Mast
3. Trig. Mast & Vanes have been painted white & black respectively. ✓
4. The Trig. was unpiled/not unpiled, dimensions now being: NEW STATION
 Description of mark: CONCRETE should be explicit, e.g. Steel plug, Brass plug, Brass plug, Bolt/Concrete Pillar
 Height of mark: 1.33 m above rock-concrete 1.33 m above G.L.
 Height of Top Vanes to Top-Mark/Top pillar plate: 1.45 m Diameter of Vanes (vertical) 0.60 m.
 Height of Cairn: m. Diameter of Cairn: m.

- Length of Mast: m. (approximate if not unpiled)
5. A rock set in conc/rock has been placed 4.74 m. bearing 233°M from Trig. Mast/pillar
 6. A rock set in conc/rock has been placed 4.96 m. bearing 342°M from Trig. Mast/pillar
 7. A set in conc/soil has been placed fd m. bearing°M from Trig. Mast/pillar
 8. A set in conc/rock has been placed fd m. bearing°M from Trig. Mast/pillar

9. Connection: to m. bearing°M
10. Connection: to m. bearing°M
11. Connection: to m. bearing°M
12. Connection: to m. bearing°M
13. Diff. Ht. 4.80 (1) is 1.42 m. below Pillar Plate
14. Diff. Ht. 6.96 (2) is 1.28 m. above Pillar Plate
15. Diff. Ht. is m. above below
16. Diff. Ht. is m. above below

Prepared by: D. VINCENT Checked: 6/2

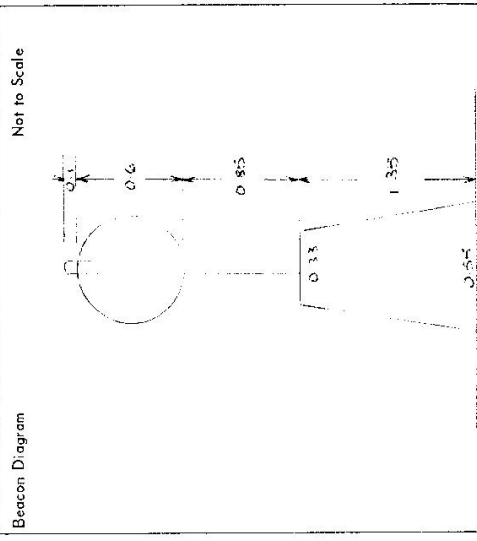

Date	Record of Station
	<u>10/21 Station erected by Spainville Centre</u>


STATION TS 10762 L SAKONVALE (P)

Owners Name: SAKONVALE CELLERY
 Current Occupant:
 Address: Dampier Mining Cellery
 Address:
 P.O. Box: 433, Singleton 2330

Access: See BOLGA 1025000

Contact Mine Manager of Sakonvale Cellery for permission to access.
 NB: Hand Hats must be worn at all times in Gallery Area

Station Diagram
 Not to Scale
 North

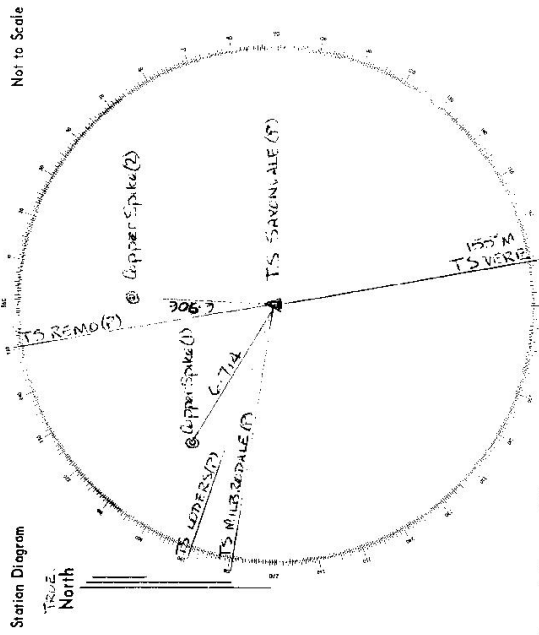

List of Observed Directions:-

Station	Direction	Station	Direction
TS WARE	170° 46' 24.2"	TS WARE	
TS WILBERFORCE (P)	275° 06' 15.3"	TS WARE	
TS WILBERFORCE (P)	255° 24' 47.7"	TS WARE	
Upper Spike (1)	300° 53' 40"	TS REMO (P)	
TS REMO (P)	330° 33' 37.0"	Upper Spike (2)	