


Department of Lands **TS 10765** STATION **TS DAISY MEDE (P)**

Integral Survey of N.S.W. **RECONNAISSANCE and MAINTENANCE REPORT**

Co: **Nandewar** Ph: **Therribry**
 Map Sheet: **Bogabri 8936 N.S.** No. **8736-N-S**
 Inspected by: **R HAMMILL** Date: **26.8.81**
 Authority: **Department of Lands** Field Book: **1716**

Beacon Diagram **Not to Scale**

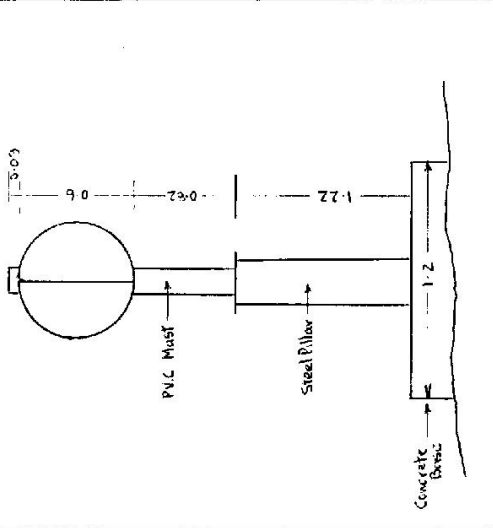

Date	Record of Station
26.8.81	Mast & Vanes Erected R Hammill

This Trig. Station has been:-

1. Completely cleared to permit 360° vision to surrounding Trigs.
2. Cleared by lances bearing..... from Trig. Mast
3. Trig. Mast & Vanes have been painted white & black respectively. ✓
4. The Trig. was unpiled/not unpiled, dimensions now being:

Description of mark **Steel Pillar**..... should be explicit, e.g. Steel plug, Brass plug, Bolt, Concrete Pillar
 Height of mark..... ^{above} 1.22 m ^{below} ~~1.22~~ m ^{above} ~~1.22~~ m ^{below} G.L.
 Height of Top Vanes to ~~Top Mast~~ Top pillar plate..... 1.42 m Diameter of Vanes (vertical)..... 0.60 m.
 Height of Cairn..... 1.22 m. Diameter of Cairn..... m.

Length of Mast..... 1.51 m. (approximate if not unpiled)

5. A. ~~55M~~ ^{38.428} set in ~~conc/rock~~ ^{conc} has been placed ~~44~~ ^{6.6} m. bearing ~~359~~ ¹¹⁹ °M from Trig. Mast/pillar

6. A ~~Copper~~ ^{Copper} spike set in ~~conc/soil~~ ^{conc} has been placed ~~44~~ ^{3.30} m. bearing ~~119~~ ¹¹⁹ °M from Trig. Mast/pillar

7. A..... set in conc/soil has been placed ~~44~~ ¹¹⁹ m. bearing..... °M from Trig. Mast/pillar

8. A..... set in ~~conc/rock~~ ^{conc} has been placed ~~44~~ ¹¹⁹ m. bearing..... °M from Trig. Mast/pillar

9. Connection. ~~38.428~~ ^{55M} to ~~spike~~ ^{Copper}..... 8.92 m. bearing ~~158~~ ¹⁵⁸ °M

10. Connection..... to..... m. bearing..... °M

11. Connection..... to..... m. bearing..... °M

12. Connection..... to..... m. bearing..... °M

13. Diff. Ht. ~~SSM~~ ^{SSM} ~~38.428~~ ^{38.428} is ~~1.463~~ ^{1.463} m. ^{below} ~~Top pillar plate~~ ^{Top pillar plate}

14. Diff. Ht. ~~Copper spike~~ ^{Copper spike} is ~~1.522~~ ^{1.522} m. ^{above} ~~Top pillar plate~~ ^{Top pillar plate}

15. Diff. Ht. is..... m. ^{above} ^{below}

16. Diff. Ht. is..... m. ^{above} ^{below}


Prepared by: **CHAMMILL** 30/10/81 Checked: **PH**

TS 10765 STATION TS DAISYMEDE (P)

Owners Name: Current Occupant:


Address: Address:

Access 28-8-1981
 Feature Conventional Vehicle
 Boggabri P.O.
 Travel north on Naurabri road to Manilla road turnoff to right.
 Iron bridge over Namoi River
 Therabri road turnoff to left.
 Travel along Therabri road until Daisymede gate on right

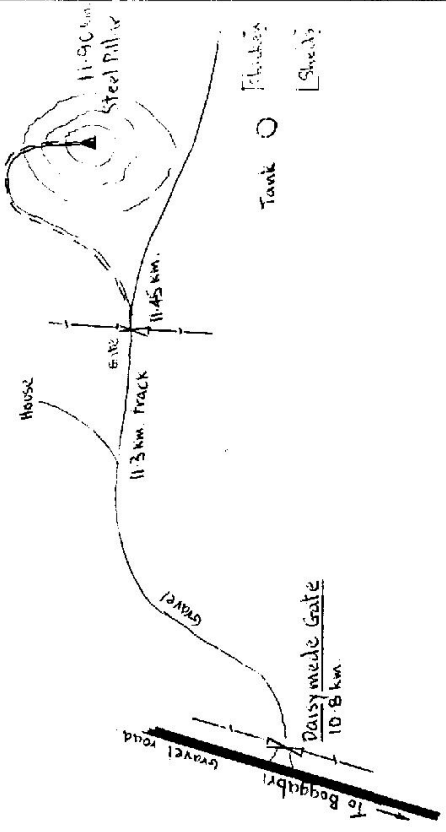

D. West, Government Printer, New South Wales . 1976

Station Diagram Not to Scale

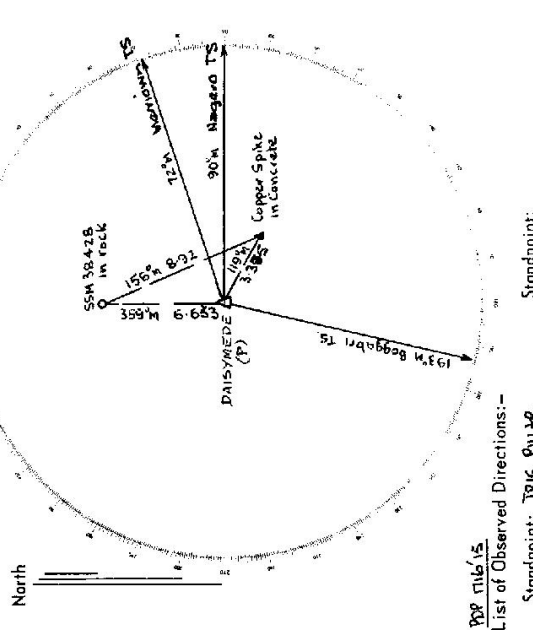

POP 116/15
 List of Observed Directions:-

Station	Direction	Station	Direction
Boggabri (P) TS	193 00 00	Copper Spike in Conc	118 45 07
SSM 3842B	156 00 41		
Naurabri TS	12 31 10		
Boggabri TS	75 29 29		
Manilla (P) TS	76 26 51		
Station	Direction	Station	Direction