


TS 10766 STATION TS MERLOWN (P)

Owners Name..... Current Occupant.....


Address..... Address.....

3-9-1981
Access
Feature **Conventional Vehicle**
 Boggabri P.O
 Travel north on Narrabri road to Manilla road turn off on right
 Iron bridge over Namoi River
 5.5 The Narrabri road turn off on left
 6.2 Continue travelling along Manilla road until turn off to Maulles Ck
 11.7 Willaroo on left
 14.3 Travel along Maulles Ck willaroo road - turn off to Goomabri
 Dripping Rock on right
 16.65 Continue travelling along Maulles Ck willaroo road until
 Merriwoun Gate on left

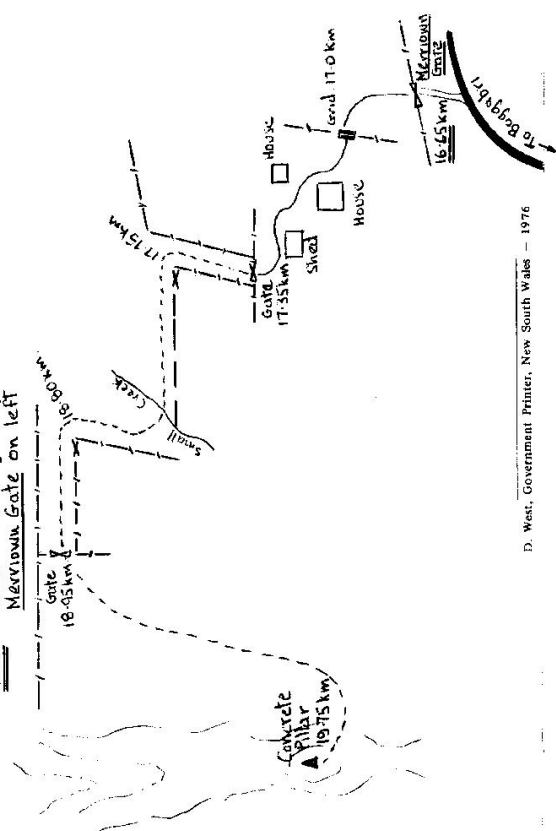

D. West, Government Printer, New South Wales - 1976

Not to Scale

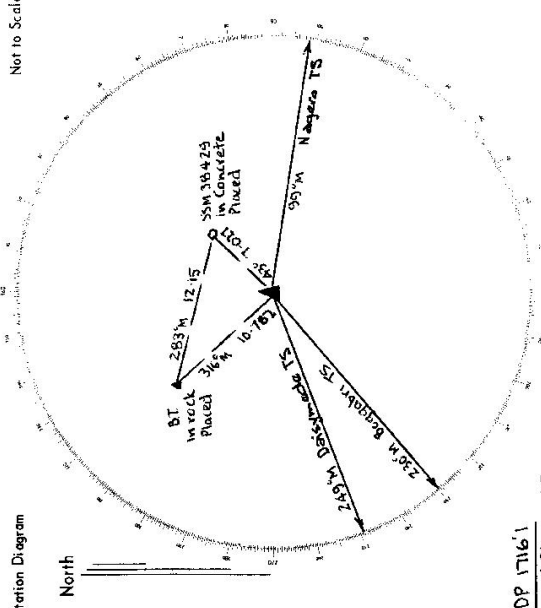

POP 1716.1

List of Observed Directions:-

Station		Standpoint:	
Station	Direction	Station	Direction
Goomabri TS	97 00 00	SSM 38A75	64 15 32
Nagoro (P) TS	120 03 59		
Boggabri (P)	755 79 03		
Daisyvade (P)	780 49 32		
Brass A	340 55 51		