

7.5.19.8

Department of Lands Integrating survey of N.S.W  
**RECONNAISSANCE and MAINTENANCE REPORT**

This Trig. Station has been: Note. Cross out word or words which do not apply

1. Completely cleared to permit 360° vision to surrounding Trigs. ✓
2. Cleared by lances bearing. ✓
3. Trig. Mast & Vanes have been painted white & black respectively. ✓
4. The Trig. was unpiled/not unpiled, dimensions now being: **NEW STATION.**

Description of mark: **Concrete pillar** should be explicit, e.g. Steel plug, Brass plug, Bolt, Concrete Pillar  
 Height of mark:  $1.35$  m <sup>above</sup> ~~below~~ **concrete**  $1.4$  m <sup>above</sup> G.L.  
 Height of Top Vanes to Top-Mark/Top pillar plate:  $1.44$  m Diameter of Vanes (vertical):  $0.60$  m.  
 Height of Cairn:  $1.35$  m. Diameter of Cairn: ..... m.  
 Length of Mast:  $1.53$  m. (approximate if not unpiled)


5. A ~~50M 32266~~ set in conc/soil has been placed/fd  $53.82$  m. bearing  $53$ °M from Trig. Mast/pillar
6. A ..... set in conc/soil has been placed/fd ..... m. bearing .....°M from Trig. Mast/pillar
7. A ..... set in conc/soil has been placed/fd ..... m. bearing .....°M from Trig. Mast/pillar
8. A ..... set in conc/rock has been placed/fd ..... m. bearing .....°M from Trig. Mast/pillar

9. Connection: ..... to ..... m. bearing .....°M
10. Connection: ..... to ..... m. bearing .....°M
11. Connection: ..... to ..... m. bearing .....°M
12. Connection: ..... to ..... m. bearing .....°M

13. Diff. Ht. ~~55.3360~~ is  $8.463$  m. <sup>below</sup> ~~above~~ **PILLAR PLATE**
14. Diff. Ht. .... is ..... m. <sup>above</sup> ~~below~~
15. Diff. Ht. .... is ..... m. <sup>above</sup> ~~below~~
16. Diff. Ht. .... is ..... m. <sup>above</sup> ~~below~~

Prepared by: A. Graham Checked: [Signature]

STATION TS 10774 **KORAGANS**  
 Co: **Northumberland** Ph: **Noncecliffe**  
 Map Sheet: **9732 IIS NEWCASTLE** No: **9232 IIS**  
 Inspected by: **A. GRAHAM** Date: **7.11.81**  
 Authority: **ISB N.C.L.E.** Field Book: **[Blank]**


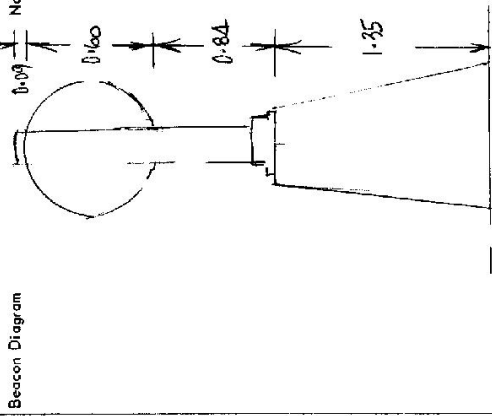


Date	Record of Station
11/2/81	Checked by <b>ASD W. GIBSON</b>

STATION T 3 10774 KOURAGANG(P)

Owners Name.....  
 Current Occupant.....  
 Address.....  
 Address.....

Access 7-12-1981  
 Located on Stockton Bridge Road.  
 approx 50metres west of Stockton Bridge  
 NTL side of Roseway.

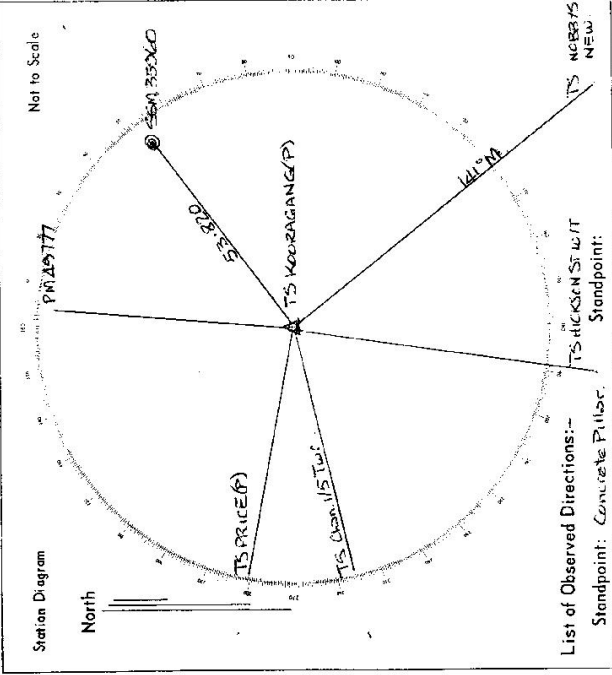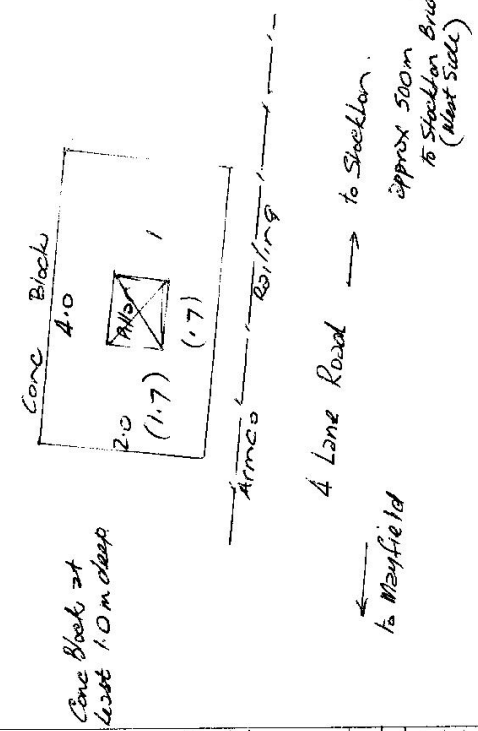

List of Observed Directions:-  
 Standpoint: Concrete Pillar.

Station	Direction	Station	Direction
TS NOBBYS NEW	141° 00' 40"		
TS HICKSON ST W/T	188° 23' 00"		
TS Obsn 1/5 Tw	256° 11' 40"		
TS PRICE	280° 48' 00"		
PM 45777	4° 23' 14"		
SSM 35060	53° 00' 12"		

D. West, Government Printer, New South Wales - 1976