
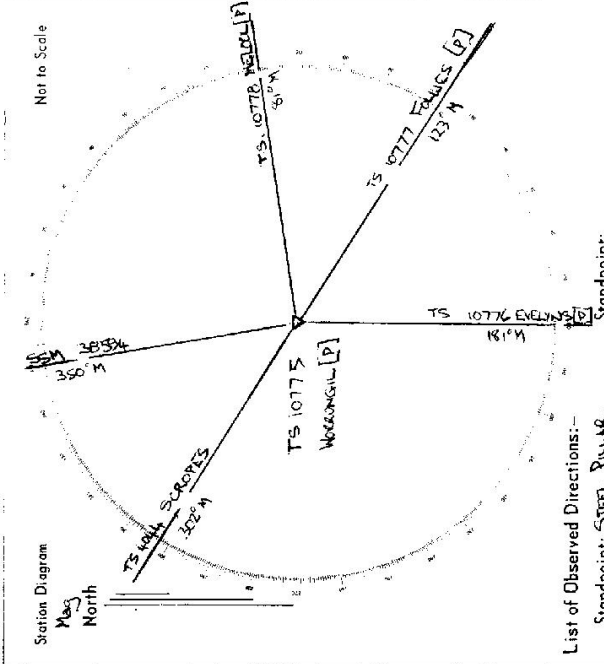


STATION TS. WONGCHIL [P] 10775
 Current Occupant J. ANDREWS
 Owners Name J. ANDREWS
 Address "GLEN LYON"
 Address "GLEN LYON"
 VIA LITTLE TOPAR
 VIA LITTLE TOPAR
 Access Via 22-9-1981
 Conventional Vehicle

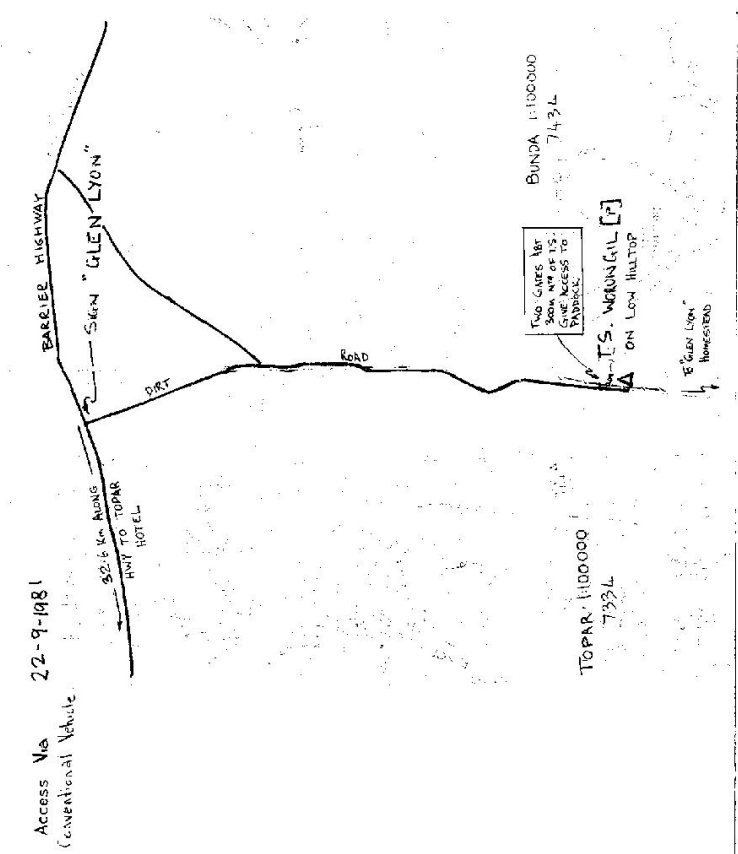

List of Observed Directions:-
 Standpoint: STEEL PILLAR.

SET 1	Station	Direction	Station	Direction
TS 4044	SCROPS	322° 00' 00"		
TS 10776	EVELINS [P]	190° 33' 53"		
TS 10778	WONGCHIL [P]	81° 15' 37"		
TS 10777	FALVES [P]	123° 03' 30"		
STEEL PILLAR				
SET 2	Station	Direction	Station	Direction
SSM 36594		350° 00' 00"		
TS 10775	EVELINS [P]	175° 42' 19"		