

7.5 (19)

Department of Lands Integraticurvey of N.S.W.
RECONNAISSANCE and MAINTENANCE REPORT

This Trig. Station has been:- Note: Cross out word or words which do not apply

1. Completely cleared to permit 360° vision to surrounding Trigs.
2. ~~Cleared by James bearing~~ from Trig-Mast
3. Trig. Mast & Vanes have been painted white & black respectively.
4. The Trig. was ~~replaced/mast supplied~~, dimensions now being: **NEW STATION**
 Description of mark: **STEEL P.M.M.** should be explicit, e.g. Steel plug, Brass plug, Bolt, Concrete Pillar
 Height of mark: 1.34 m ^{above} ~~below~~ concrete ^{above} ~~below~~ G.L.
 Height of Top Vanes to Top-Mark/Top pillar plate: 1.21 m Diameter of Vanes (vertical): 0.60 m.

- ~~Height of Conn. m. Diameter of Conn. m.~~
- Length of Mast 1.29 m. (approximate if not unplied)
5. ~~A. set in conc./rock has been placed/fd m. bearing m. from Trig-Mast/pillar~~
 6. A. set in conc./soil has been placed/fd m. bearing m. from Trig. Mast/pillar
 7. A. set in conc./soil has been placed/fd m. bearing m. from Trig. Mast/pillar
 8. A. set in conc./rock has been placed/fd m. bearing m. from Trig. Mast/pillar
 9. Connection to m. bearing m.
 10. Connection to m. bearing m.
 11. Connection to m. bearing m.
 12. Connection to m. bearing m.
 13. Diff. Ht. is m. ^{above} ~~below~~
 14. Diff. Ht. is m. ^{above} ~~below~~
 15. Diff. Ht. is m. ^{above} ~~below~~
 16. Diff. Ht. is m. ^{above} ~~below~~
- Prepared by: Ch. ADE Checked: [Signature]


STATION **T.S. EVELYNS [P] 10776**

Co: **TANDORA** Ph: **—**

Map Sheet: **TOPAR 1:100 000** No: **7334**

Inspected by: **H.G. HELSHAM** Date: **25/9/81**

Authority: **I.S.B.** Field Book: **PDP 1773**

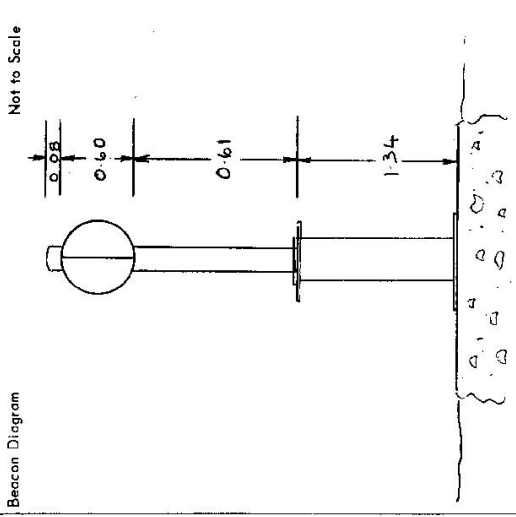

Date	Record of Station
22/9/81	PILLAR ERECTED
25/9/81	STATION OCCUPIED

