

STATION T.S. FOLLES (P) 10777

Current Occupant:


Owners Name:

Address:

Address:


Access 15-9-1981

Station Diagram Not to Scale

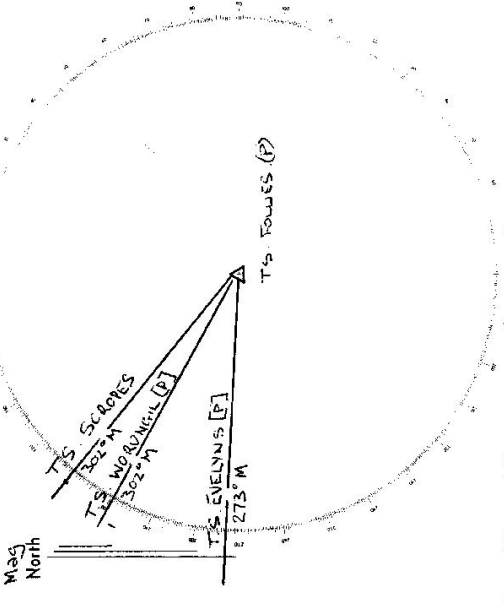

List of Observed Directions:-

Standpoint: STEEL PILLAR		Standpoint:	
SET 1	Station	Direction	Station
	T.S. EVELYN'S (F) 10776	273° 00' 00"	
	T.S. MORGANALL (P) 10775	302° 31' 23"	
STEEL PILLAR			
SET 2	Station	Direction	Station
	T.S. SCAPES 4044	302° 31' 23"	
	T.S. MORGANALL (P) 10775		

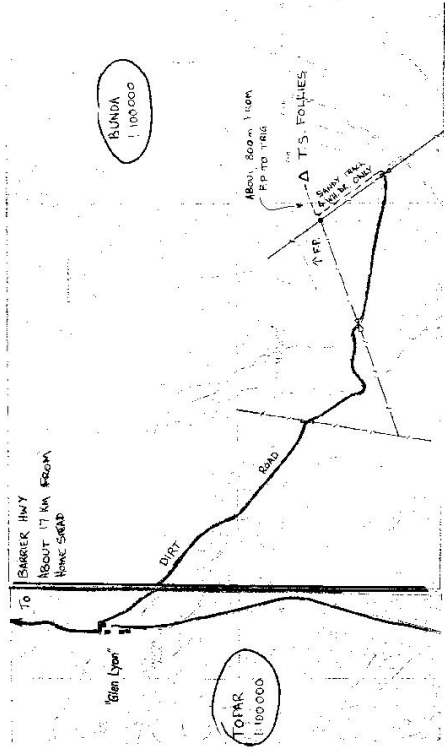

D. West, Government Printer, New South Wales - 1976