

7-193

Department of Lands

Integrative Survey of N.S.W.

RECONNAISSANCE and MAINTENANCE REPORT

This Trig. Station has been:-

Note: Cross out word or words which do not apply

1. Completely cleared to permit 360° vision to surrounding trigps.
2. Cleared by James bearing..... from Trig. Mast
3. Trig. Mast & Vanes have been painted white & black respectively.
4. The Trig. was unspiled, not unspiled, dimensions new being: NEW STATION  
PASSIVE STATION ONLY CLASS AIDP MAIN SPILE OF RUSSIAN ORTHODOX CHURCH, JOHN  
Description of mark: STREET, CABRAMAITA should be explicit, e.g. Steel plug, Brass plug, Ball, Concrete Pillar

Height of mark..... m above rock, concrete ..... m below G.L.

Height of Top Vanes to Top Mark/Top pillar plate..... m Diameter of Vanes (vertical)..... m.

Height of Cairn..... m Diameter of Cairn..... m

Length of Mast..... m (approximate if not unspiled)

5. A..... set in conc/rock has been placed/fd ..... m, bearing .....°M from Trig. Mast/pillar
6. A..... set in conc/soil has been placed/fd ..... m, bearing .....°M from Trig. Mast/pillar
7. A..... set in conc/soil has been placed/fd ..... m, bearing .....°M from Trig. Mast/pillar
8. A..... set in conc/rock has been placed/fd ..... m, bearing .....°M from Trig. Mast/pillar

9. Connection..... to..... m, bearing.....°M

10. Connection..... to..... m, bearing.....°M

11. Connection..... to..... m, bearing.....°M

12. Connection..... to..... m, bearing.....°M

13. Diff. Ht. .... is ..... m, above below

14. Diff. Ht. .... is ..... m, above below

15. Diff. Ht. .... is ..... m, above below

16. Diff. Ht. .... is ..... m, above below

Prepared by: N.L. HURCUM

Checked: *[Signature]*

STATION TS 10779 CABRAMAITA ORTHODOX

Co: CUMBERLAND Ph: ST LUKE


Map Sheet: 1:10000 FAIRFIELD No: 9145

Inspected by: N.L. HURCUM Date: 28 JANUARY 1982

Authority INTEGRATION SURVEYS Field Book:

Beacon Diagram  
PASSIVE STATION  
CLASS AIDP  
SPILE

Not to Scale

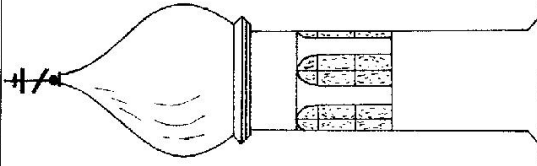

Date

Record of Station

28-1-82 CROSS MARKED AS PASSIVE STATION





