

7-103


Department of Lands
 Integration Su of N.S.W.
RECONNAISSANCE and MAINTENANCE REPORT

STATION TS 10781 SALTWATER (P)

This Trig. Station has been:-
 Note: Cross out word or words which do not apply

Co: THURMAN
 Ph: 734427

Map Sheet: M50-11-100-1
 No. of sheets: 11 N
 Inspected by: A. NICKELL
 Date: 18-2-22
 Authority: SURVEY CENTRAL BRANCH
 Field Book: TP1757/1
 Beacon Diagram
 SECTION 21
 Not to Scale

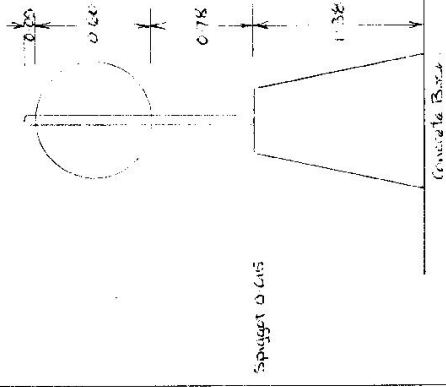

1. Completely cleared to permit 360° vision to surrounding Trigs. ✓
2. Cleared by ~~tanes~~ bearing..... from Trig. Mast
3. Trig. Mast & Vanes have been painted white & black respectively. ✓
4. The Trig. was unpiled/not unpiled, dimensions now being: NE to STATION
 Description of mark... Concrete Pillar should be explicitly e.g. Steel plug, Brass plug, Bolt, Concrete Pillar
 Height of mark... 1.38 m ^{above} ~~below~~ concrete G.L.
 Height of Top Vanes to ~~Top Mast~~ Top pillar plate... 38 m Diameter of Vanes (vertical) 0.40 m.
 Height of ~~Centre~~ Centre..... m. Diameter of ~~Centre~~..... m.
 Length of Mast..... m. (approximate if not unpiled)

5. ~~Apparent~~ set in conc/rock has been placed/ 4.34 m. bearing..... 124 °M from Trig. Mast/pillar
6. ~~Conc. Pipe~~ set in conc/soil has been placed/ 4.3 m. bearing..... 46 °M from Trig. Mast/pillar
7. A..... set in conc/soil has been placed/ fd..... m. bearing..... °M from Trig. Mast/pillar
8. A..... set in conc/rock has been placed/ fd..... m. bearing..... °M from Trig. Mast/pillar

9. Connection ~~to G.L. Pipe~~ to G.L. Pipe..... m. bearing..... °M
10. Connection..... to..... m. bearing..... °M
11. Connection..... to..... m. bearing..... °M
12. Connection..... to..... m. bearing..... °M
13. Diff. Ht. ~~Concrete Pillar~~ is 1.38 m. ^{above} ~~below~~ Pillar Plate.....
14. Diff. Ht. ~~Conc. Pipe~~ is 1.38 m. ^{above} ~~below~~ Pillar Plate.....
15. Diff. Ht. is..... m. ^{above} ~~below~~.....
16. Diff. Ht. is..... m. ^{above} ~~below~~.....

Prepared by: D V
 Checked:


Date	Record of Station
Feb 22	Pillar erected

STATION T.S 10781 SALTWATER (P)

Owners Name: Drayton Gallery
 Current Occupant: Drayton Gallery

Address:

Access: See MUSEUMS BOOK 1:25000 map
 Central Mt. Road Street - Gallery Building
 at Drayton Gallery for access

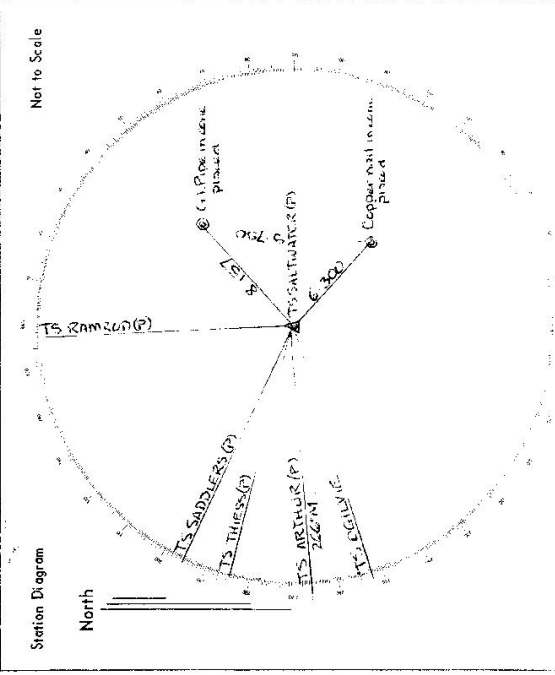

List of Observed Directions:-

Station: Pillar		Standpoint: Equipment	
Station	Direction	Station	Direction
TS ARTHUR (P)	246° 00' 00"	TS SALTWATER (P)	0° 00' 00"
TS THURSDAY (P)	254° 16' 30"	TS 700	261° 05' 42"
TS SADDLERS (P)	253° 35' 01"		
TS RAMSON (P)	337° 12' 16"		
TS TUDOR (P)	47° 48' 00"		
↓			
Station	Direction	Station	Direction
TS RAMSON (P)	152° 01' 31"		
TS SADDLERS (P)	252° 00' 15"		