

STATION MINNAMURRA


TS 10786

Current Occupant... SEE OWNER

Owners Name... M. N. S. & D. B.


Address

Address... 86 CROWN ST. WOLLONGONG

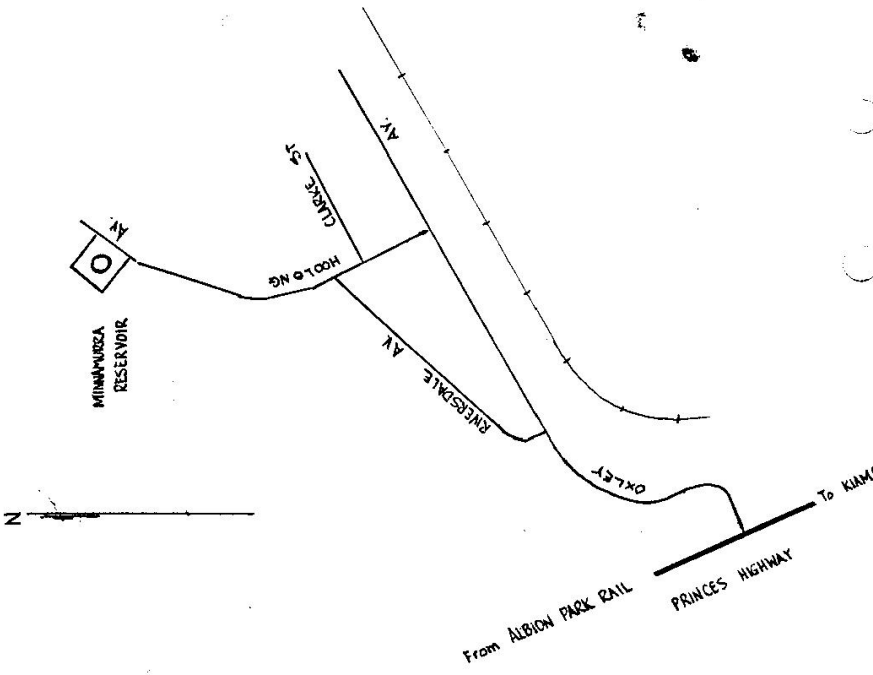

Not to Scale

Station Diagram

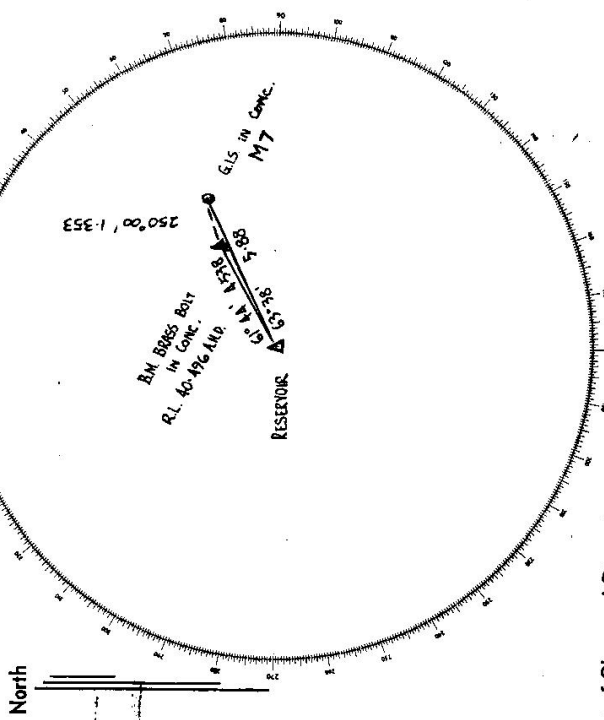

List of Observed Directions:-

| Standpoint: RESERVOIR | | Standpoint: G.I.S. M7 | |
|-----------------------|--------------|-----------------------|--------------|
| Station | Direction | Station | Direction |
| STOCKYARD [P1] | 290° 21' 39" | M9 | 75A° 21' 47" |
| P.M. 50478 | 257° 14' 14" | M8 | 67° 32' 31" |
| JANABARA [P1] | 260° 24' 15" | P.M. 28269 | 69° 07' 11" |
| | | P.M. 28350 | 166° 38' 32" |
| | | P.M. 28276 | 18A° 18' 17" |
| Station | Direction | Station | Direction |
| | | | |
| | | | |
| | | | |