

7-10-9

Department of Lands Integrative Survey of N.S.W.
RECONNAISSANCE and MAINTENANCE REPORT

This Trig. Station has been: Note: Cross out word or words which do not apply

1. Completely cleared to permit 360° vision to surrounding Trigs. ✓
2. Cleared by James bearing from Trig. Mast
3. Trig. Mast & Vanes have been painted white & black respectively.
4. The Trig. was unpiled/~~not unpiled~~, dimensions now being: NEW STATION

Description of mark: Concrete pillar should be explicit, e.g. Steel plug, Brass plug, Bolt, Concrete Pillar
 Height of mark: 4.82m ^{above} ~~below~~ rock/concrete G.L.
 Height of Top Vanes to Top Mark/Top pillar plate: 1.44 m Diameter of Vanes (vertical): 0.60 m.
 Height of Comm: 1.37 m. Diameter of Comm: 24 x 65 m.
 Length of Mast: 1.53 m. (approximate if not unpiled)


5. A. set in conc/rock has been placed/fd m. bearing °M from Trig. Mast/pillar
6. A. set in conc/soil has been placed/fd m. bearing °M from Trig. Mast/pillar
7. A. set in conc/soil has been placed/fd m. bearing °M from Trig. Mast/pillar
8. A. set in conc/rock has been placed/fd m. bearing °M from Trig. Mast/pillar

9. Connection: to m. bearing °M
10. Connection: to m. bearing °M
11. Connection: to m. bearing °M
12. Connection: to m. bearing °M

13. Diff. Ht. is m. ^{above} ~~below~~
14. Diff. Ht. is m. ^{above} ~~below~~
15. Diff. Ht. is m. ^{above} ~~below~~
16. Diff. Ht. is m. ^{above} ~~below~~

Prepared by CAF Checked: SL

STATION TS KATTANG [P] 10791
 Co-Northumberland Ph: Newcastle
 Map Sheet: Newcastle No: 9232
 Inspected by: A. Duffy Date: 23-2-87
 Authority ISB NCLC Field Book: 1195/S

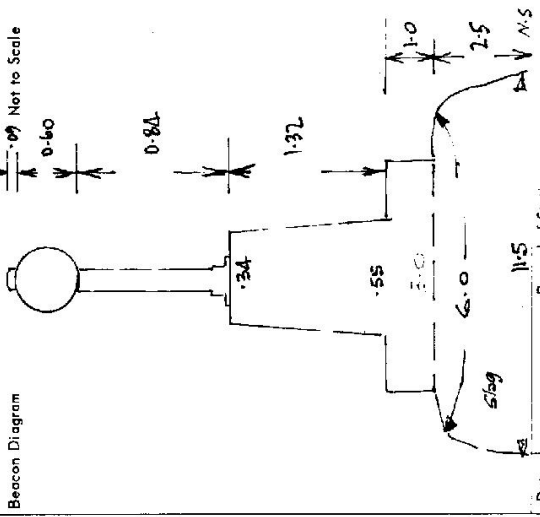

Beacon Diagram
 Date: 19/2/87
 Record of Station
 Pillar Erected by 8119

