

TS 10796

Department of Lands Integrating survey of N.S.W.
RECONNAISSANCE and MAINTENANCE REPORT


STATION (SLAUGHTERHOUSE T.S.) SSM20421
 Co: URANA Ph: CLEAR HILL
 Map Sheet: OAKLANDS No: 8126-N
 Inspected by: L. HAYES Date: 3-6-77
 Authority: Integrated Survey's Field Book: 540/2

This Trig. Station has been: Beacon Diagram Not to Scale

1. Completely cleared to permit 360° vision to surrounding Trigs.
2. Cleared by fanes bearing from Trig. Mast
3. Trig. Mast & Vanes have been painted white & black respectively. ✓
4. The Trig. was unpiled/not unpiled, dimensions now being:
 - Description of mark: 5.5M. 70.421 should be explicit, e.g. Steel plug, Brass plug, Bolt, Concrete Pillar
 - Height of mark: 0.01 m above rock concrete 0.1 m above G.L.
 - Height of Top Vanes to Top Mark/Top disc plate: 4.51 m Diameter of Vanes (vertical): 0.92 m.
 - Height of Cairn: m Diameter of Cairn: m.

5. A. set in conc/rock has been placed/fd m. bearing°M from Trig. Mast/pillar
6. A. set in conc./soil has been placed/fd m. bearing°M from Trig. Mast/pillar
7. A. set in conc./soil has been placed/fd m. bearing°M from Trig. Mast/pillar
8. A. set in conc/rock has been placed/fd m. bearing°M from Trig. Mast/pillar
9. Connection: to : m. bearing°M
10. Connection: to : m. bearing°M
11. Connection: to : m. bearing°M
12. Connection: to : m. bearing°M
13. Diff. Ht. is m. above below
14. Diff. Ht. is m. above below
15. Diff. Ht. is m. above below
16. Diff. Ht. is m. above below

Prepared by: OH Checked: OH

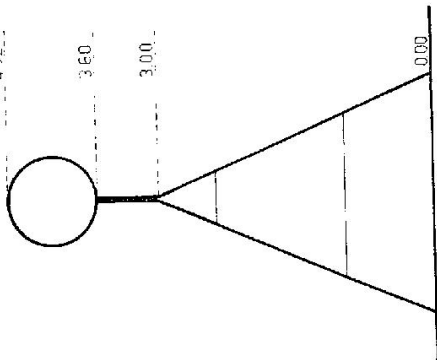

Date	Record of Station
10.76	ARMY SURVEY TRIG. BEACON ERECTED

