

TS 10797

Integrating survey of N.S.W.

RECONNAISSANCE and MAINTENANCE REPORT

Department of Lands

This Trig. Station has been:-

Note: Cross out word or words which do not apply

1. Completely cleared to permit 360° vision to surrounding Trigs.
2. Cleared by limes bearing..... from Trig. Mast
3. Trig. Mast & Vanes have been painted white & black respectively.
4. The Trig. was unpiled/not unpiled, dimensions now being:
 - Description of mark: State Survey Mark 20420..... should be explicit, e.g. Steel plug, Brass plug, Bolt, Concrete Pillar
 - Height of mark..... 0.010..... m ^{above} concrete 0.01..... m ^{above} G.L.
 - Height of Top Vanes to Top Mark/Top plate..... 4.50..... m Diameter of Vanes (vertical)... 0.52 m.
 - Height of Centre..... m. Diameter of Centre..... m.

5. A..... set in conc/rock has been placed/fd..... m. bearing.....°M from Trig. Mast/pillar
6. A..... set in conc/soil has been placed/fd..... m. bearing.....°M from Trig. Mast/pillar
7. A..... set in conc/soil has been placed/fd..... m. bearing.....°M from Trig. Mast/pillar
8. A..... set in conc/rock has been placed/fd..... m. bearing.....°M from Trig. Mast/pillar


9. Connection..... to..... m. bearing.....°M
10. Connection..... to..... m. bearing.....°M
11. Connection..... to..... m. bearing.....°M
12. Connection..... to..... m. bearing.....°M
13. Diff. Ht. is..... m. ^{above} below
14. Diff. Ht. is..... m. ^{above} below
15. Diff. Ht. is..... m. ^{above} below
16. Diff. Ht. is..... m. ^{above} below

Prepared by: *DN*

Checked: *et*

STATION (HEATHERLY T.S.)
 Co: URANA
 Map Sheet: OAKLANDS
 Inspected by: L. HAYES
 Authority: Investigation Surveys
 No: 8126-N
 Date: 3-2-77
 Field Book: 540/1

Beacon Diagram
 Not to Scale
 4.52 4.50
 3.50 3.50
 2.50 2.50

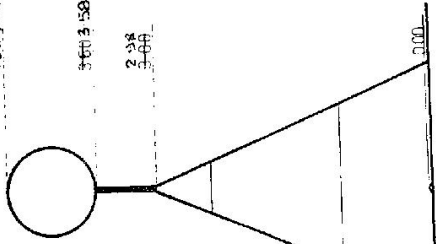

Date 10.76
 Record of Station
 ARMY SURVEY TRIG, BEACON ERECTED

