

STATION WANGA' ONG T.S., SSM20422


TS 10798

Owners Name..... Current Occupant.....

Address..... Address.....


Oct 1976

Access FROM OAKLANDS POST OFFICE DRIVE EAST FOR 3 km TO SLAUGHTERHOUSE ROAD RUN RIGHT (SOUTH) ONTO SLAUGHTERHOUSE ROAD AND PROCEED FOR 5.5 km TURN RIGHT THROUGH GATE (WEST) AND PROCEED UP HILL (SMALL TRACK) TO DOUBLE GATES APPROX 0.7 km PROCEED THROUGH FIRST GATE THEN TURN LEFT (SOUTH) THROUGH GATE AND PROCEED ALONG RIDGE FOR APPROX 0.4 km TO TRIG.

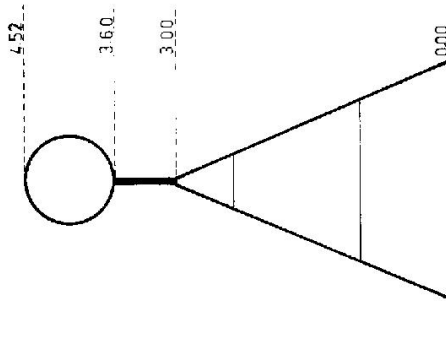

D. West., Government Printer, New South Wales - 1976

Station Diagram Not to Scale

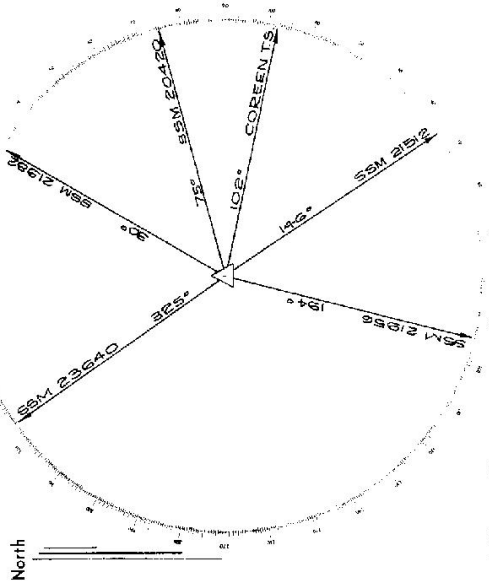

List of Observed Directions:—

Standpoint:		Station:		Direction:	
Station	Direction	Station	Direction	Station	Direction
SSM 20420	0 00 00	SSM 23640			
COREEN T.S.		SSM 21982			
SSM 21512					
SSM 21956					
Station	Direction	Station	Direction	Station	Direction