

TS: 1080

GEODETTIC SURVEY OF N.S.W.

CENTRAL MAPPING AUTHORITY

GEODETTIC STATION RECONNAISSANCE and MAINTENANCE REPORT

STATION: **BOOTHERAGANDRA**

No.: **2797**

MAP SHEET SCALE: **1:250 000**


INSPECTED BY: **G. C. HANNA**

AUTHORITY: **C. M. A.**

DATE: **19/5/79**

FIELD BOOK:

- Description:
- Cleared by lanes bearing.....  
*Note: Cross out word or words which do not apply*
  - Mast & Vanes have been painted white & black respectively.
  - The station/pillar was unpiled/not unpiled/constructed on.....  
19..... dimensions now being:
- Description of mark..... should be explicit, e.g., S/Steel Pillar Plate, Steel plug, Brass plug, Bolt, G.I. Pipe
- Height of mark.....m. above below rock/concrete; Mark is.....m. above below G.L.
- Height of Top Vanes to Top Mark/Pillar plate.....m. Diameter of Vanes (vertical).....m.
- Height of Cairn.....m. Diameter of Cairn.....m. Name Plate found/not found/placed.
- Length of Mast.....m. (approximate if not unpiled)
- A.....set in conc/rock has been placed/found, bearing.....° M from Mast/Plug/Pillar
  - A.....set in conc/rock has been placed/found, bearing.....° M from Mast/Plug/Pillar
  - A.....set in conc/rock has been placed/found, bearing.....° M from Mast/Plug/Pillar
  - A.....set in conc/rock has been placed/found, bearing.....° M from Mast/Plug/Pillar
8. Action required:.....

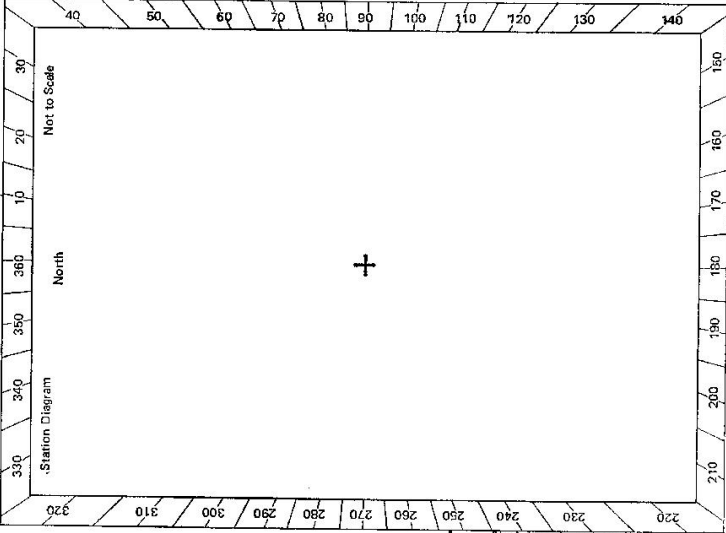

STANDPOINT:

Mark	Direction	Horiz. Distance	Height Difference	Mark	Direction	Horiz. Distance	Height Difference
			above standpt.				below standpt.
			below standpt.				above standpt.
			above standpt.				below standpt.
			below standpt.				above standpt.
Prepared by: *G. C. Hanna* 21/5/79

Checked:

Checked




CENTRAL MAPPING AUTHORITY  
 GEODETTIC SURVEY OF M.S.W.  
 GEODETTIC STATION RECONNAISSANCE and MAINTENANCE REPORT  
 No.: 1080

STATION: **BOOTHACANDRA**  
 MAP SHEET: **1:250 000**  
 SCALE: **LARGELLIGO**  
 INSPECTED BY: **K.HADJON**  
 DATE: **18-8-82**  
 AUTHORITY: **C.M.A**  
 FIELD BOOK: **C 201**

Description:  
 Note: *Cross out word or words which do not apply*  
 1. Cleared by lanes bearing **31° → 75° 97° 100° 135° → 142° 218° → 236° 266° → 275°, 292° 356° → 360°** from Trig. Mast  
 2. ~~Mast & Vanes have been painted white & black respectively.~~  
 3. The station/~~pillar~~ was unpainted/~~reconnaissanced~~ on **18-8-82**, dimensions now being:  
 Description of mark **Mast** should be explicit, e.g., S/Steel Pillar Plate, Steel plug, Brass plug, Bolt, G.I. Pipe  
 Height of mark **0.35** m. ~~above~~ rock/~~concrete~~; Mark is **0.1** m. ~~above~~ G.L.  
 Height of Top Vanes to Top Mark/~~Plate~~ **2.455** m. ✓ Diameter of Vanes (vertical) **1.0** m.  
 Height of Cairn **1.1** m. Diameter of Cairn **2.1** m. ~~Name-Plate found/not found/plate~~  
 Length of Mast **2.99** m. (approximate if not unpiled)  
 4. A **C.V. Nail** set in conc./~~rock~~ has been ~~placed~~/found, bearing **357°** M from ~~Mast~~/Plug/~~Pillar~~  
 5. A **G.I. Pipe** set in conc./~~rock~~ has been ~~placed~~/found, bearing **44°** M from ~~Mast~~/Plug/~~Pillar~~  
 6. A set in conc./rock has been placed/found, bearing **°** M from Mast/Plug/Pillar  
 7. A set in conc./rock has been placed/found, bearing **°** M from Mast/Plug/Pillar  
 8. Action required: **Nil**

Mark	Direction	Horiz. Distance	Height Difference	Direction	Horiz. Distance	Height Difference
WARABALONE	0° 00' 00"		above standpt.	0° 00' 00"		above standpt.
C.V. Nail	357° 58'	3.349	above standpt.	87° 19' 27.8"		above standpt.
G.I. Pipe	55° 57'	5.419	below standpt.	94° 00' 30"	4.503	below standpt.
CHAIRBROCK	87° 18' 57.0"		below standpt.	180° 00' 30"	3.344	below standpt.
			below standpt.			below standpt.
			below standpt.			below standpt.
			below standpt.			below standpt.
			below standpt.			below standpt.

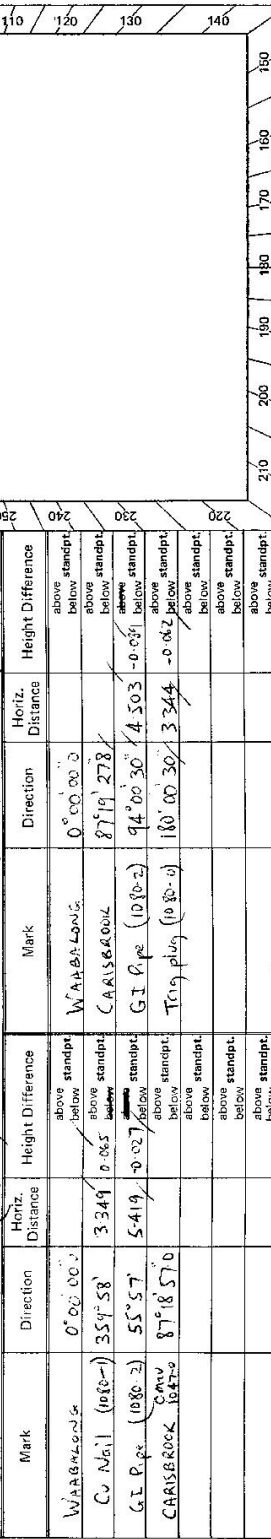

STANDPOINT: **TRIC PLUG (1080-0)**      **WARABALONE (1080-1)**  
 Prepared by: **K.HADJON 27-8-82**      Checked: **J. Fanning, 15/11/82** Noted on U.T.M. Card  
 S. 2738-1


S: 2733-2 D. West, Government Printer

STATION BOOTHERA LANDORA 1080

Owner's Name: TR 40060  
 Address: .....  
 Phone: .....  
 Current Owner: Lessee HS & PJ Mitchell  
 Address: Yallawa, Mitchell's Road, Mitchell's Prop  
 Phone: .....

**ACCESS**  
 Access Report of 18/10/82 was found suitable/unsuitable.

- 00 HILLSTON P.O. HEAD north east.
- 06 Turn right towards Lake Coyelligo
- 07 Cross railway
- 120 Turn right into Mitchell's Road.
- 220 Pass Mitchell's Road on left
- 256 Pass Sloones Road on right
- 318 Road turns hard left
- 323 Turn right
- 329 Owner's residence on left. "Yarrawa" (if no one home go down lane to next house)
- 343 Turn right go through western most gate.
- 367 Cross dam wall
- 370 Gate
- 372 Turn right off track at blazed tree Head up ridge to tree line and find blazed tree
- 401 Through saddle.
- 419 Leave vehicle at double blazed tree About 200m walk to trig

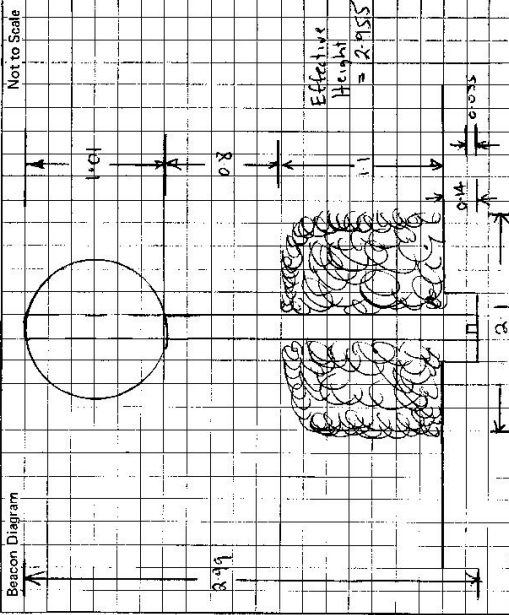

This section to be completed by officer constructing pillar.

Original station mark found/not found.

Description of mark: .....

Original beacon found/not found.

Description of beacon: .....

Height Top of Vane to Top Mark.....m.

Height of mark.....m. above G.L. below

Diameter of Vane.....m.

Original Beacon has/has not been destroyed by me.

Date .....

Record of Station