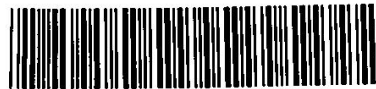


LOCALITY SKETCH PLAN

Provisional Sketch

**TS10801**Local Government Area **Upper Hunter**Town/Suburb/Locality **Rouchel**

Approx MGA Coordinate: Zone

Description of Mark

From Various Sources


Created 19-02-2008

E:

N:

- KM
- 0.0 Aberdeen Police Station head north towards Scone
 - 0.4 Turn right on road towards "Rouchel"
 - 0.6 Level Crossing
 - 7.4 Turn right through double gates near cattle yard (note owners house is about 200m further along road to Rouchel through gate with "Brookfield" sign).
 - 7.8 Gate.
 - 8.5 Gate.
 - 9.5 Gate. Turn right immediately and go through another gate. following track roughly parallel with fence.
 - 10.5 Pass dam 10m away on R.H.S.
 - 10.6 Cross creek
 - 11.0 Take left hand fork and follow track around saddle and up to trig
 - 11.5 TRIG

NOTE: Locked gate at 7.4 km. Key obtainable from
Mr Andrews - "Woodside", The Rouchel Rd, ABERDEEN -
abt. 3km east.

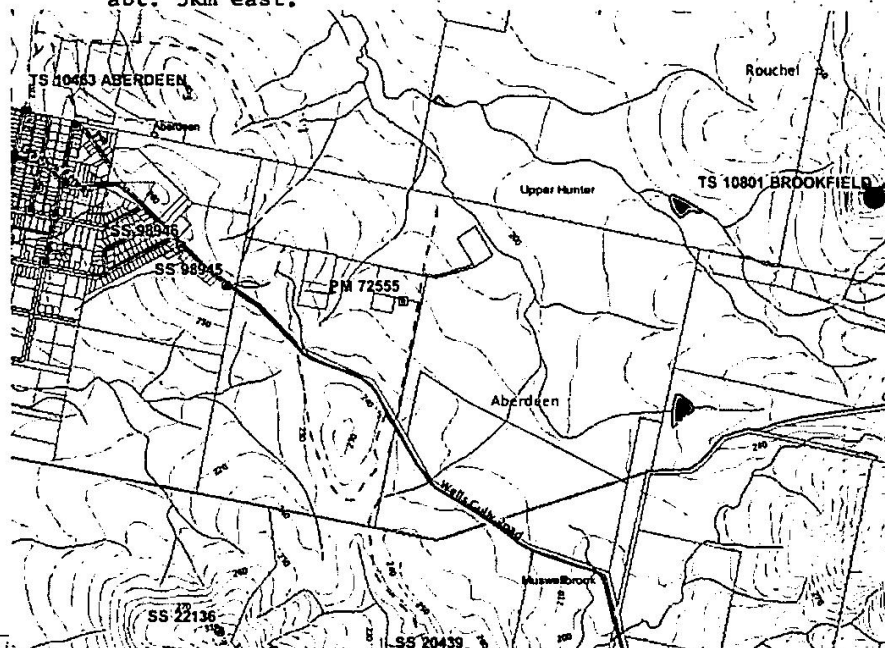

Please use black ink only

SURVEYING REGULATION			
MARK	AHD	SOURCE	DATE
HEIGHT DETERMINED BY - DIFF. LEVELLING (Specify) - TRIG HEIGHTING			
ADOPTED MARKS - GPS			

Measurements are in metres

TS 10801
Brookfield(P)

PM

Replaces

SS

I certify that the mark has been placed/found
and numbered as detailed hereon.

Signed:

Name:

Organisation
placing mark:

Date mark placed/found: / /

Ref: