

Integral Survey of N.S.W.

RECONNAISSANCE and MAINTENANCE REPORT

Department of Lands

STATION TS 10803 ROWAN [P]

This Trig. Station has been:-

Note: Cross out word or words which do not apply

1. Completely cleared to permit 360° vision to surrounding trigs.
2. Cleared by lances bearing 285°M, 42°M, 80°M, 175°M, 180°M, 225°M from Trig. Mast
3. Trig. Mast & Vanes have been painted white & black respectively.
4. The Trig. ~~was supplied with~~ ~~concrete~~ ~~concrete~~ dimensions now being:

Description of mark... Roof Pillar... should be explicit, e.g. Steel plug, Brass plug, Bolt, Concrete Pillar
 Height of mark... 1.30 m above ~~concrete~~ concrete 1.35 m above G.L.
 Height of Top Vanes to Top Mast/Top pillar plate 1.46 m Diameter of Vanes (vertical) 0.6 m.
 Height of Cap... m. Diameter of Cap... m.

Length of Mast 2.84 m. (approximate if not unplied)

5. A C.S. set in concrete has been placed/d 7.581 m. bearing 250° M from Trig. Mast/pillar
6. A C.S. set in conc/soil has been placed/d 7.647 m. bearing 118° M from Trig. Mast/pillar
7. A set in conc/soil has been placed/d m. bearing °M from Trig. Mast/pillar
8. A set in conc/rock has been placed/d m. bearing °M from Trig. Mast/pillar

9. Connection Pillar to C.S. (1) 7.581 m. bearing 250° M
10. Connection C.S. (2) to C.S. (1) 13.893 m. bearing 273° M
11. Connection Pillar to C.S. (2) 7.647 m. bearing 118° M
12. Connection to m. bearing °M

13. Diff. Ht. C.S. (1) is 1.592 m. above Pillar Plate
14. Diff. Ht. C.S. (2) is 1.220 m. below Pillar Plate
15. Diff. Ht. C.S. (1) is 0.362 m. below C.S. (2)
16. Diff. Ht. is m. below m. below

Prepared by: J.M.P

Checked: [Signature]

Co: DURHAM Ph: ROWAN

Map Sheet: ABERDEEN

No: 9033-I-S


Inspected by: P. HARRISON

Date: 13.2.1980


Authority: LAURIE, MONTGOMERIE & PARTNERS, PTY. LTD.

Field Book: 1472

Beacon Diagram: Not to Scale

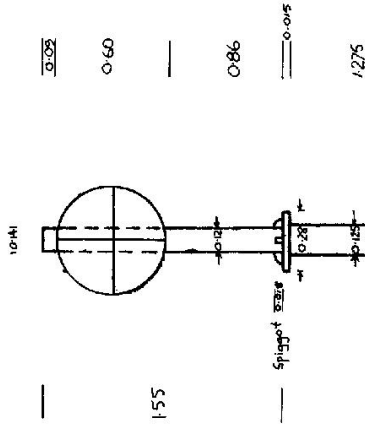

Date	Record of Station
1980	Station Established, Witness marks placed

STATION: TS 10803  ROWAN (P)

Owners Name..... Current Occupant.....
 Address..... Address.....

13.2.1980

Access 0.0 Muswellbrook P.O. head North along New England H'way towards
Aberdeen

2.85 Turn right at sign "McCully's Gap 9"

2.9 Level Crossing

3.1 Pass road to Power Station on right hand side

4.1 Pass road to St. Heliers on left hand side

5.0 Pass house on right hand side

5.5 Turn right over grid and travel along ~~Power's~~ Road (Gravel)
LIMESTONE

1.78 6.7 Cattle Grid

1.9 6.8 Trig on right hand side

JAN '95