

7-5-19-3

Department of Lands Integrative Survey of N.S.W
RECONNAISSANCE and MAINTENANCE REPORT

This Trig. Station has been: Note: Cross out word or words which do not apply

1. ~~Completely cleared to permit 360° vision to surrounding trigs.~~
2. Cleared by lanes bearing $172^{\circ} 04' E$ $58.7 M$ from Trig. Mast
3. Trig. Mast & Vanes have been painted white & black respectively. ✓
4. The Trig. was unpiled/~~not supplied~~, dimensions now being: NEW STATION


Description of mark: CONCRETE PILLAR should be explicit, e.g. Steel plug, Brass plug, Bolt, Concrete Pillar
 Height of mark: 1.40 m ^{above} ~~below~~ concrete 1.50 m ^{above} ~~below~~ G.L.
 Height of Top Vanes to Top Mark/Top pillar plate: 1.30 m Diameter of Vanes (vertical): 0.6 m.
 Height of Cap 1.40 m. Diameter of Cap $6 \times 6 \times 3.3$ m.

- Length of Mast: 1.47 m. (approximate if not unpiled)
5. A. G.P. set in conc/~~soil~~ has been placed/~~fd~~ 3.435 m. bearing 36° from Trig. ~~Mast~~/pillar
 6. A. C.S. set in conc/~~soil~~ has been placed/~~fd~~ 3.115 m. bearing 152° from Trig. ~~Mast~~/pillar
 7. A. set in conc/~~soil~~ has been placed/~~fd~~ m. bearing $^{\circ}$ from Trig. Mast/pillar
 8. A. set in conc/~~rock~~ has been placed/~~fd~~ m. bearing $^{\circ}$ from Trig. Mast/pillar

9. Connection G.P. to C.S. 5.740 m. bearing 356°
10. Connection: to: m. bearing $^{\circ}$
11. Connection: to: m. bearing $^{\circ}$
12. Connection: to: m. bearing $^{\circ}$
13. Diff. Ht. Pillar plate is 1.678 m. ^{above} ~~below~~ GP1
14. Diff. Ht. Pillar plate is 1.396 m. ^{above} ~~below~~ CS1
15. Diff. Ht. GP1 is 0.282 m. ^{above} ~~below~~ CS1
16. Diff. Ht. is m. ^{above} ~~below~~ GP1

Prepared by: RD Checked: R Duffin

STATION TS 10807 (MORISSET (P1))
 Co: NORTHUMBERLAND Ph: MANDALONG
 Map Sheet: GOSFORD No: 9131
 Inspected by: A DUFFY Date: 17.7.82
 Authority: S C REH MOLE Field Book: DDP1902

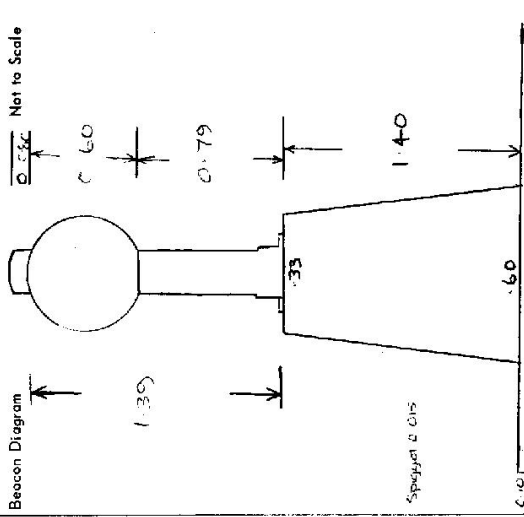

Date	Record of Station
8/1/82	Pillar Erected

STATION TS 010807 (MORISSET [P])


Owners Name... MANDALONGS COLLIERY Current Occupant... MANDALONGS COLLIERY

Address... MORISSET Address... MORISSET

Access 17-7-1982

Feature

- Km 0.0 Morisset P.O. Travel west.
- 1.1 Cross Freemans Rd into Mandalong Rd
- 1.6 Left turn onto track, follow track up hill to Trig.
- 2.0 Trig

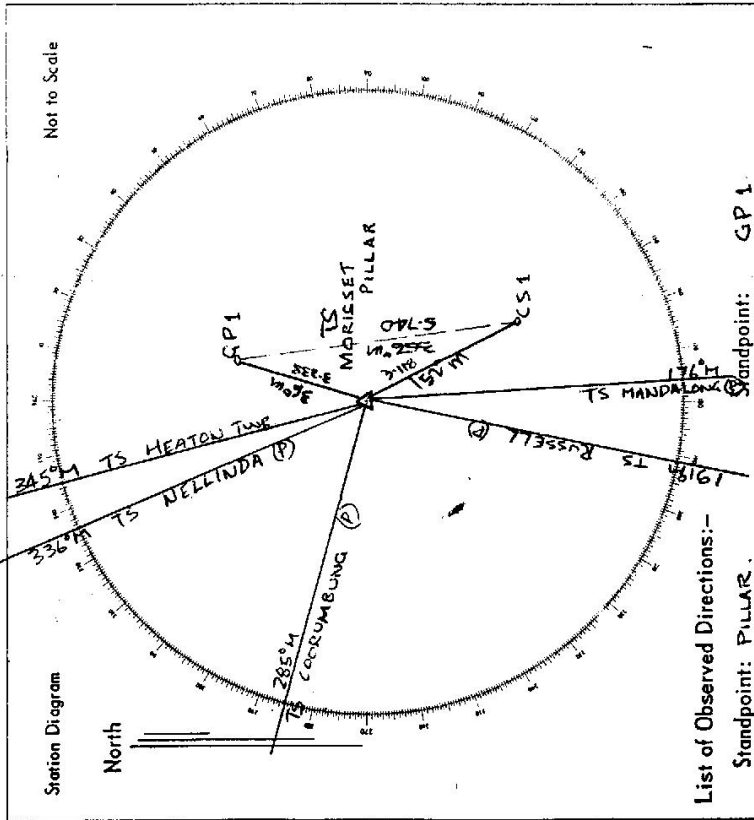

List of Observed Directions:-

Station	Direction	Station	Direction
TS RUSSELL (P)	0° 00' 00"	TS MORISSET (P)	0° 00' 00"
TS COORUMBUNG (P)	93° 50' 31"	TS CS 1	335° 03' 47"
TS NELLINDA (P)	145° 27' 41"		
TS HEATON TUNE	151° 51' 02"		
GPI	167° 25' 03"		

Station	Direction	Station	Direction
CS 1	316° 30' 32"		
TS MANDALONG (P)	345° 13' 12"		

