

75-19-3

Department of Lands

Integral Survey of N.S.W  
RECONNAISSANCE and MAINTENANCE REPORT

STATION TS 10812 DUSODIE [P]

This Trig. Station has been:-

- 1. ~~Completely cleared to permit 360° vision to surrounding trig.~~
- 2. Cleared by lanes bearing 170° Mag to 178° Mag from Trig. Mast
- 3. ~~Trig. Mast & Vanes have been painted white & black respectively.~~

4. The Trig. was unpiled/~~not supplied~~, dimensions now being:

Description of mark Concrete Pillar should be explicit, e.g. Steel plug, Brass plug, Belt, Concrete Pillar

Height of mark..... m above rock/concrete 1.32 m above G.L.  
 Height of Top Vanes to Top Mark/Top pillar-plate..... m Diameter of Vanes (vertical)..... m

Height of Cairn 1.32 m. Diameter of Cairn 32 x 55 m.

Length of Mast..... m (approximate if not upright) No Mast and Vanes

- 5. ~~A set in conc/rock has been placed/rd..... m bearing.....°M from Trig. Mast/pillar~~
- 6. A set in conc/soil has been placed/rd..... m bearing.....°M from Trig. Mast/pillar
- 7. A set in conc/soil has been placed/rd..... m bearing.....°M from Trig. Mast/pillar
- 8. A set in conc/rock has been placed/rd..... m bearing.....°M from Trig. Mast/pillar


- 9. Connection..... to..... m bearing.....°M
- 10. Connection..... to..... m bearing.....°M
- 11. Connection..... to..... m bearing.....°M
- 12. Connection..... to..... m bearing.....°M

- 13. Diff. Ht. is..... m above below
- 14. Diff. Ht. is..... m above below
- 15. Diff. Ht. is..... m above below
- 16. Diff. Ht. is..... m above below

Prepared by: B. Agland 7-2-83 Checked:

Co: **GLOUCESTER** Ph: **WANGAT**  
 Map Sheet: **CHICHESTER** No: **9233-IV-S**  
 Inspected by: **B. AGLAND** Date: **22-12-82**  
 Authority: **H. D. W. B.** Field Book:

Beacon Diagram Not to Scale

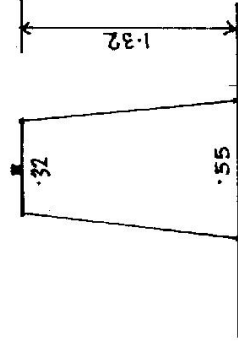


Date	Record of Station
	<b>ERECTED</b>

STATION TS 10812 DUSODIE [P]

Owners Name: H.D.W.B.  
 Current Occupant: H.D.W.B.  
 Address: Hunter Street  
 Newcastle West 2302

Access: From Dungog take road to chichester Dam.  
 At entrance to H.D.W.B. property follow main access road to dam. Follow map below.

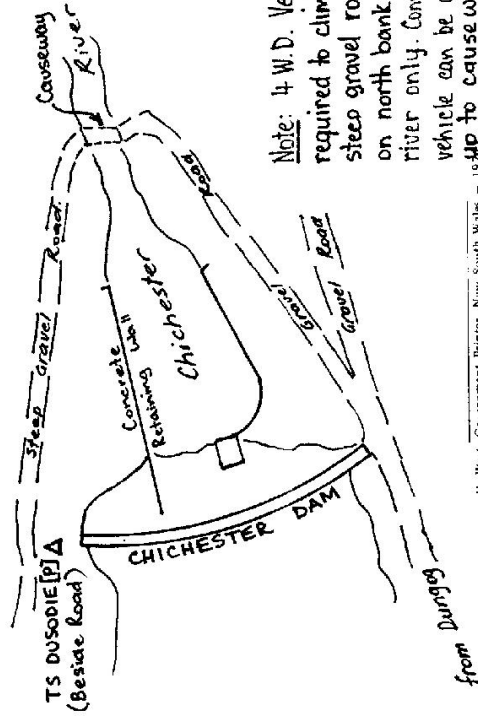

D. West, Government Printer, New South Wales - 1984p to cause way.

