

75-19.3

10814


Department of Lands
 Integrating Survey of N.S.W.
 RECONNAISSANCE and MAINTENANCE REPORT

STATION TS ~~10814~~ (Kooragang [P2])
 Co: Northumberland
 Ph: Newcastle


Map Sheet: 9932 IIS NEWCASTLE
 No: 9932 IIS
 Date: 24. 8. 87

Inspected by: A GREENMAN
 Authority: LANDS - SURV. CONTROL BRG
 Field Book: 1908 PDP

Beacon Diagram
 ELEVATION
 Net to Scale

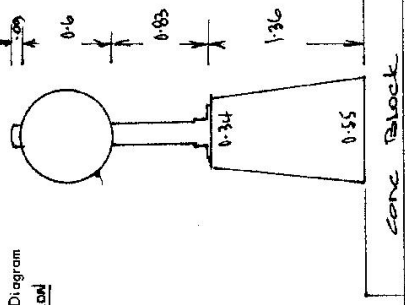

PLAN

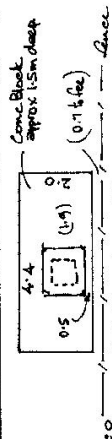

Area of Structure
 Record of Station
 Date
 20/10/87
 1111m Elected by BHP

This Trig. Station has been:

1. Completely cleared to permit 360° vision to surrounding Trigs. ✓
2. Cleared by James bearing from Trig. Mast
3. Trig. Mast & Vanes have been painted white & black respectively. ✓
4. The Trig. was unpiled/not unpiled, dimensions now being: NEW STATION

Description of mark: Concrete pillar should be explicit, e.g. Steel plug, Brass plug, Brass plug, Bolt, Concrete Pillar

Height of mark: 1.36 m above rock/concrete above below EL.

Height of Top Vanes to Top pillar plate: 1.43 m Diameter of Vanes (vertical): 0.60 m.

Height of Cairn: 1.36 m. Diameter of Cairn: 55 x 34 m.

Length of Mast: 1.57 m. (approximate if not unpiled)

5. A. set in conc/rock has been placed/fd m. bearing°M from Trig. Mast/pillar
6. A. set in conc/soil has been placed/fd m. bearing°M from Trig. Mast/pillar
7. A. set in conc/soil has been placed/fd m. bearing°M from Trig. Mast/pillar
8. A. set in conc/rock has been placed/fd m. bearing°M from Trig. Mast/pillar

9. Connection: to m. bearing°M

10. Connection: to m. bearing°M

11. Connection: to m. bearing°M

12. Connection: to m. bearing°M

13. Diff. Ht. is m. above below

14. Diff. Ht. is m. above below

15. Diff. Ht. is m. above below


16. Diff. Ht. is m. above below

Prepared by: [Signature] Checked: [Signature]

STATION TS ~~10774~~ ¹⁰⁸¹⁴ KOORAGANG P2

Owners Name: Public Road
 Current Occupant: Public Road
 Address:

Access 24-8-1982
 Located on Stockton Bridge Road approx. 500metres west of
 Stockton Bridge - Nth side of roadway.

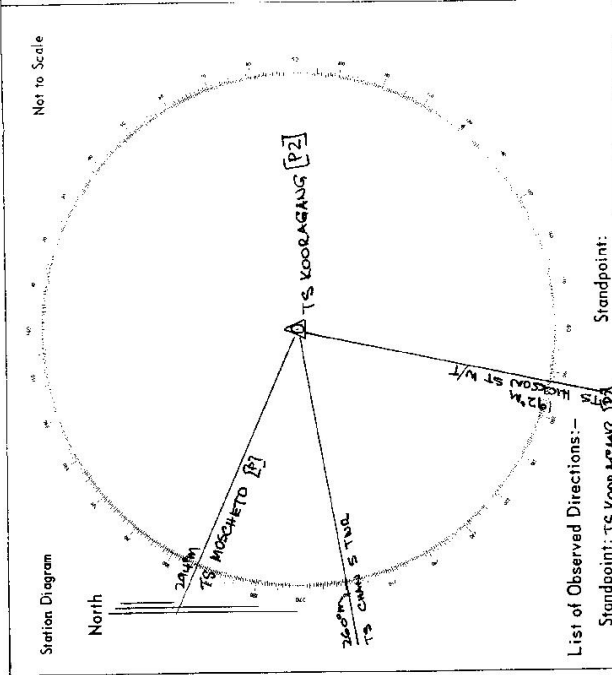

List of Observed Directions:-

Standpoint: TS KOORAGANG [P2]	
Station	Direction
TS CHAM S TMR	300° 00'
TS MOSCHE TO [P2]	210° 12'
TS HICKSON ST W/T	120° 51' 16.5"