

LAND INFORMATION CENTRE

GEODETIC SURVEY OF A.S.M.


GEODETIC STATION RECONNAISSANCE and MAINTENANCE REPORT

STATION: **GARROORIGANG TS** No.: **10815**

MAP SHEET SCALE 1:250 000 **GOWLBURN** 1:250 000

INSPECTED BY: **C. FORD** DATE: **23-2-95.**

AUTHORITY: **L. I. C** FIELD BOOK: **---**

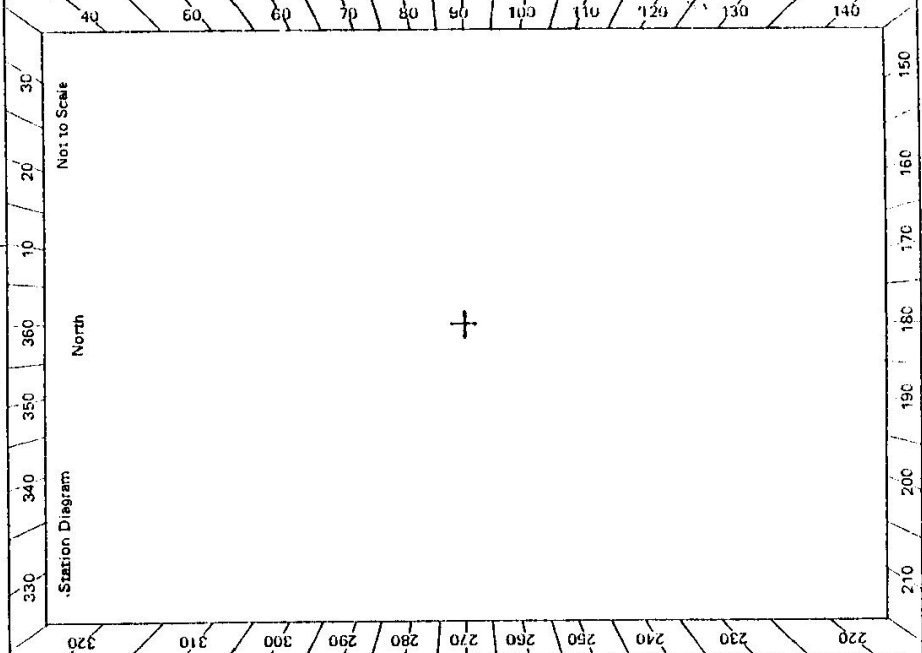

- Description:
1. Cleared by vanes bearing..... from Trig. Mast
 2. Mast & Vanes have been painted white & black respectively. ✓
 3. The station/pillar was unpiled/not unpiled/constructed on..... 19....., dimensions now being: Description of mark **ROCK IN CONC ON GROUND** should be explicit, e.g. S/Steel Pillar Plate, Steel plug, Brass plug, Bolt, G.I. Pipe
 - Height of mark.....m. ^{above} rock/concrete; Mark is.....m. ^{above} G.L.
 - Height of Top Vanes to Top Mark/Pillar plate.....m. Diameter of Vanes (vertical).....m.
 - Height of Cairn.....m. Diameter of Cairn.....m. Name Plate found/not found/placed.
 - Length of Mast.....m. (approximate if not unpiled)
 4. A..... **S.S.M.** set in conc/rock has been placed/found, bearing..... **65**° M from Mast/Plug/Pillar
 5. A..... set in conc/rock has been placed/found, bearing.....° M from Mast/Plug/Pillar
 6. A..... set in conc/rock has been placed/found, bearing.....° M from Mast/Plug/Pillar
 7. A..... set in conc/rock has been placed/found, bearing.....° M from Mast/Plug/Pillar
 8. Action required:.....

STANDPOINT:				STANDPOINT:			
Mark	Direction	Horiz. Distance	Height Difference	Mark	Direction	Horiz. Distance	Height Difference
			above standpt.				above standpt.
			below				below
			above standpt.				above standpt.
			below				below
Noted on U.T.M. Card

Checked

Checked:

Prepared by: **S.A.D.**

<p>STATION GARROORIGANG TS 10815</p> <p>Owner's Name: MR. PETER BLADWELL Address: INDUS AT BUILDERS & CRAZERS OPP. GOULBURN JAIL Phone: MARCH 1945.</p> <p>Current Occupant: Address: Phone:</p> <p>Access Report of:/19 was found suitable/unsuitable. ACCESS SOUTH END OF SLOANE ST NEAR AMPOL/CALTEX DEPOTS TURN RIGHT INTO TSR JUST BEFORE GONG UNDER H.W.Y BRIDGE 1 KM GATE TO RIGHT SOIL CONSERVATION LAND (YOU GO PAST TRIG UP ON HILL)</p>	<p>No: to Scale</p>	<p>This section to be completed by officer constructing pillar.</p> <p>Original station mark found/not found.</p> <p>Description of mark:</p> <p>Original beacon found/not found.</p> <p>Description of beacon:m.</p> <p>Height Top of Vanes to Top Markm.</p> <p>Height of markm. above G.L. below</p> <p>Diameter of Vanesm. Height of Cairnm.</p> <p>Original Beacon has/has not been destroyed by me.</p>
		<p>Date</p> <p>Record of Station</p> <p>.....</p> <p>.....</p> <p>.....</p> <p>.....</p> <p>.....</p> <p>.....</p> <p>.....</p>