

7-5-10-3

STATION TS 10819 (DUDLEY WT)

Co: Northumberland Ph: Kaitiaki

Map Sheet: 9132

Inspected by: K. DUFFY


Authority: S.C.B. NGLG

Beacon Diagram

Date: 29.3.83

Field Book: PP 919

No: Not to Scale

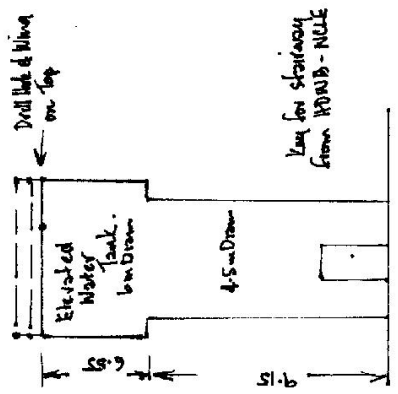

Date	Record of Station
TS 10819	TS 10819

Department of Lands Integratic Survey of N.S.W. RECONNAISSANCE and MAINTENANCE REPORT

This Trig. Station has been: Note: Cross out word or words which do not apply

1. Completely cleared to permit 360° vision to surrounding Trigs. ✓
2. Cleared by Jones-bearing from Trig-Mast
3. Trig-Mast & Vanes have been painted white & black respectively.
4. The Trig-vanes were not supplied, dimensions new bearings

Description of mark: Drill hole in Mast should be explicit, e.g. Steel plug, Brass plug, Bolt, Concrete Pillar

Height of mark: 15.7 m above G.L.

Height of Top Vane to Top Mast/Top pillar plate: m Diameter of Vane (vertical) m.

Height of Cap: m Diameter of Cap: m

Length of Mast: m (approximate if not supplied)

5. Sentile of Tank 15 set in conc/rock has been placed/d 1.644 m bearing 128°M from Trig. Mast/pillar

6. A set in conc/soil has been placed/d m bearing °M from Trig. Mast/pillar

7. A set in conc/soil has been placed/d m bearing °M from Trig. Mast/pillar

8. A set in conc/rock has been placed/d m bearing °M from Trig. Mast/pillar

9. Connection to m bearing °M

10. Connection to m bearing °M

11. Connection to m bearing °M

12. Connection to m bearing °M

13. Diff. Ht. is m ^{above}/_{below}

14. Diff. Ht. is m ^{above}/_{below}

15. Diff. Ht. is m ^{above}/_{below}

16. Diff. Ht. is m ^{above}/_{below}

Prepared by: K. Duffy Checked: K. Duffy

