

7-4-98

Department of Lands

RECONNAISSANCE and MAINTENANCE REPORT

STATION TS 10822 C JAROY

This Trig. Station has been:-

Note: Cross out word or words which do not apply

1. Completely cleared to permit 360° vision to surrounding Trigs. /
2. Cleared by lanes bearing..... from Trig. Mast
3. Trig. Mast & Vanes have been painted ~~white & black~~ **white & black respectively.**
4. The Trig. was ~~erected~~ ~~not~~ ~~unpiled~~, dimensions now being:

Description of mark ~~STEEL SQUARED BEACON~~ should be explicit, e.g. Steel plug, Brass plug, Bolt, G.I. Pipe

Height of mark..... m above below rock/concrete m above below G.L.
 Diameter of Vanes (vertical)..... m.

Height of Cairn..... m. Diameter of Cairn..... m.

Length of Mast..... m. (approximate if not unpiled)

5. A ~~ROCK MARK~~ ^{STEEL PLUG} set in ~~concrete~~ has been placed ^{1.54} ~~1.52~~ m. bearing ¹⁵⁴ ~~152~~ from Trig. Mast
6. A..... set in conc/soil has been placed..... m. bearing..... from Trig. Mast
7. A..... set in conc/soil has been placed..... m. bearing..... from Trig. Mast
8. A..... set in conc/rock has been placed..... m. bearing..... from Trig. Mast

9. Connection..... to..... m. bearing.....

10. Connection..... to..... m. bearing.....

11. Connection..... to..... m. bearing.....

12. Connection..... to..... m. bearing.....

13. Diff. Ht. **PLATFORM** is **18.71** m. ^{above} ~~below~~ **PM 3000**

14. Diff. Ht. is..... m. ^{above} ~~below~~

15. Diff. Ht. is..... m. ^{above} ~~below~~



16. Diff. Ht. is..... m. ^{above} ~~below~~

Prepared by: **MWS & DB**

Noted on U.T.M. Card

Checked: **DB**

Co: **CUMBERLAND** | Ph: **NARRABEEN**
 Map Sheet: **LONG REEF** | No. **L 2760-1**
 Inspected by: **MWS & DB** | Date: _____
 Authority: **MWS & DB** | Field Book: _____
 Beacon Diagram: **Not to Scale**

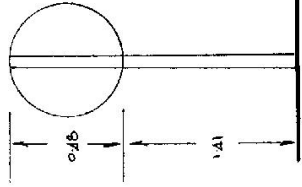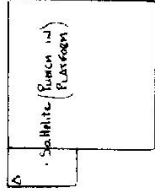

Date: _____ Record of Station


1982 **MUST** erected.

Checked

STATION TS 10822 **GALLARDY**


Owners Name: **MNS&D.B**
 Current Occupant:

Address:

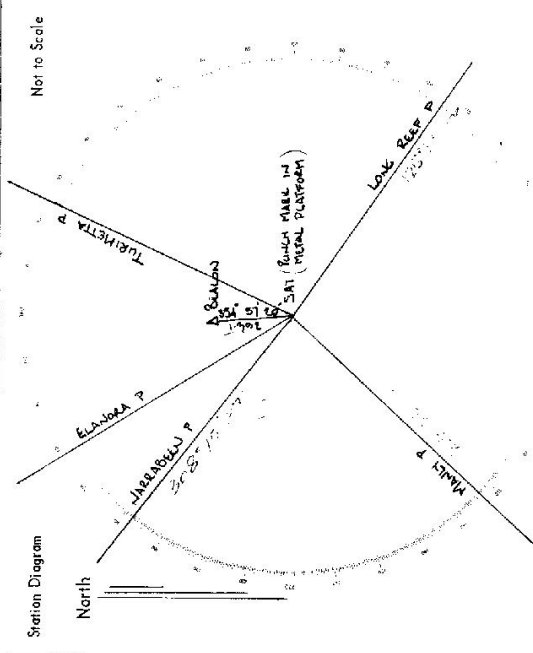

List of Observed Directions:-
 Standpoint: **SAT**
 Direction: **A cross wind N**

Station	Direction	Station	Direction
TS 4416 TURIMETA P	0 00 00	TS 4416 TURIMETA P	0 00 00
TS 10822 LAKE REEF P	100 12 35	TS 10822 LAKE REEF P	100 12 35
TS 2762 MANLI P	198 52 02	TS 2762 MANLI P	198 52 02
TS 3312 JABABELE P	185 02 26	TS 3312 JABABELE P	185 02 26
TS 19246 ELASORA P	502 49 72	TS 19246 ELASORA P	502 49 72

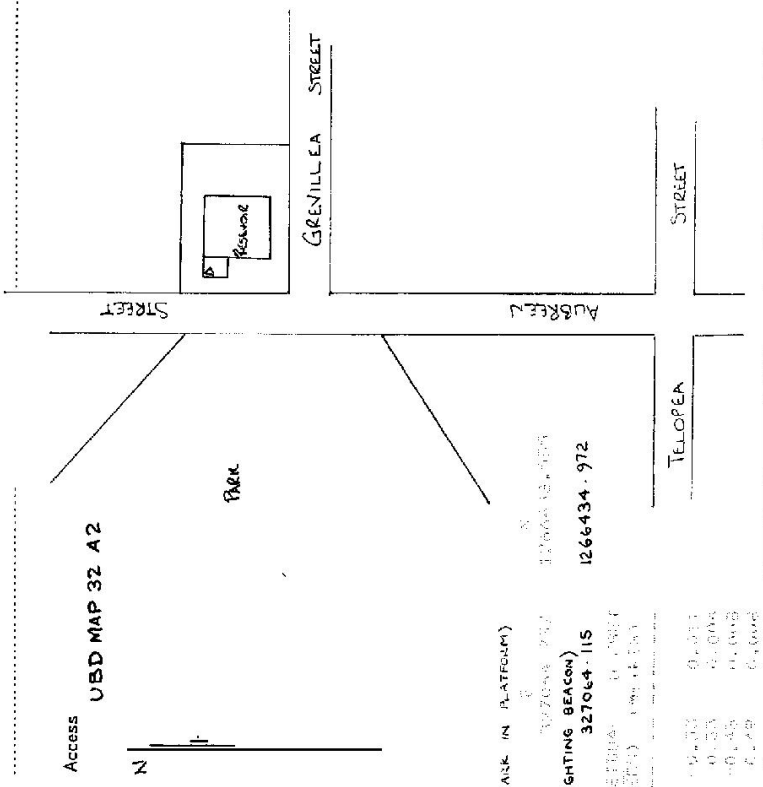

1266434 - 972

STATION TS 10822 **COLLAROY**


Owners Name: **M.W.S. & D.B.**

Current Occupant:

Address:

Address:

Station Diagram Not to Scale

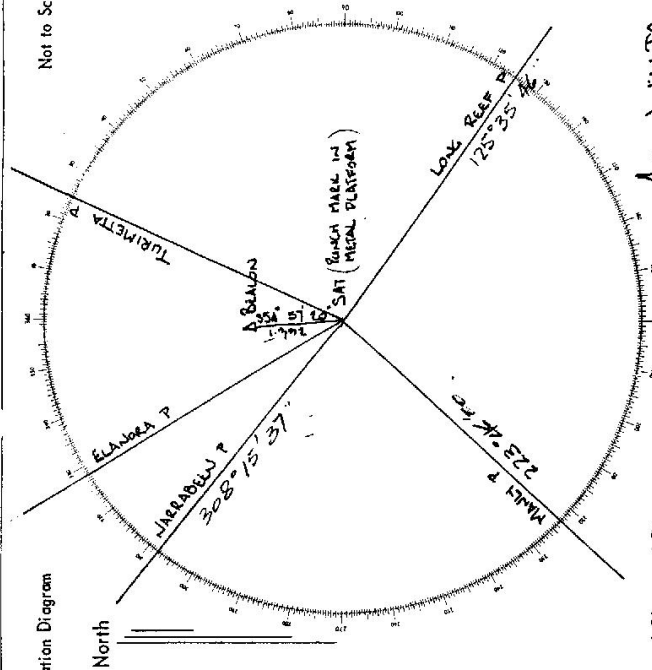

Access **UBD MAP 32 A2**

N

PARK

GREVILLEA STREET

STREET

AUBREY STREET

TELOPEA STREET

List of Observed Directions:-

Standpoint: **SAT**

Station	Direction	Station	Direction
TS 4476 TURIMETTA P	0° 00' 00"	RESECTION AT COLLAROY:	(RANG MARK IN PLATFORM)
TS 1080 LONG REEF P	100° 02' 05"		E
TS 2964 MAMLY P	198° 52' 02"	COMPUTED CO-ORDINATES ARE	327064.237
TS 3342 JARRAMEN P	188° 02' 26"	(STEEL SIGHTING BEACON)	1266433.585
TS 1946 ELANORA P	302° 49' 52"		1266434.972
TO OBSERVED	PL.-GRD COMP. PLANE	TRUE DIST	RESIDUAL OFFSET
STATION DIRECTION	(SECS)	BEARING	(METRES)
			(SECS)

TURIMETT	0	0	0.00	-0.26	25	13	52.19	4088.563	-0.53	0.011
LONG REE	100	22	13.50	0.10	125	36	6.92	2459.643	0.33	0.004
MAMLY	198	52	2.60	0.19	223	45	55.34	3897.771	-0.43	0.008
NARRA.P	283	2	26.00	-0.14	308	16	19.34	3408.570	0.49	0.008
ELANORA	302	49	52.20	-0.24	528	3	45.08	4173.372	0.14	0.003