

27-10-84

Department of Lands

Integration of N.S.W.

RECONNAISSANCE and MAINTENANCE REPORT

This Trig. Station has been:

Note: Cross out word or words which do not apply

1. Completely cleared to permit 360° vision to surrounding Trig.

2. Cleared by lances bearing SEE LIST OF OBSERVED DIRECTIONS from Trig. Mast

3. Trig. Mast & Vanes have been painted white & black respectively

4. The Trig. was ~~emptied~~ ^{not emptied} ~~dimensions now being~~

Description of mark: S. STEEL PIN IN ROCK should be explicit, e.g. Steel plug, Brass plug, Ball Concrete Pillar

Height of mark: 0.01 m above rock ~~concrete~~ ^{above} ~~below~~ G.L.

Height of Top Vanes to Top Mark/Top pillar plate: Diameter of Vane (vertical) m.

Height of Cairn: 0 m. Diameter of Cairn: 0 m.

Length of Mast: 0 m. (approximate if not supplied)

5. A. BOLT 1 set in ~~conc~~ ^{rock} has been placed/d 5.17 m. bearing 187 °M from Trig. Mast/pillar

6. A. BOLT 2 set in ~~conc~~ ^{rock} has been placed/d 14.81 m. bearing 300 °M from Trig. Mast/pillar

7. A. DIAGONAL set in ~~conc~~ ^{rock} has been placed/d 2.80 m. bearing 70 °M from Trig. Mast/pillar

8. A. set in conc/rock has been placed/d 0 m. bearing 0 °M from Trig. Mast/pillar

9. Connection: to to m. bearing 0 °M

10. Connection: to to m. bearing 0 °M

11. Connection: to to m. bearing 0 °M

12. Connection: to to m. bearing 0 °M

13. Diff. Ht. BOLT 1 is 0.28 m. ~~above~~ ^{below} S. STEEL PIN

14. Diff. Ht. BOLT 2 is 0.19 m. ~~above~~ ^{below} S. STEEL PIN

15. Diff. Ht. DIAGONAL is 1.06 m. ~~above~~ ^{below} S. STEEL PIN

16. Diff. Ht. is is m. ~~above~~ ^{below}

Prepared by: L.G. TREVERROW Checked: [Signature]

STATION TS CRATER ROCK 10825

Co: CAMDEN Ph: DENDROBIUM

Map Sheet: COUDEAUX No: 7392

Inspected by: L.G. TREVERROW Date: 17-10-84

Authority: SURVEY CONTROL BRANCH Field Book:

Beacon Diagram Not to Scale

NO BEACON OR PILLAR.

Date 17-10-84 Record of Station

MARK PLACED BY BHP


TRIM MAINTENANCE RENEW L.G. TREVERROW.

STATION TS. CRATER ROCK 10825


Current Occupant... M.W.S. & D.B.
Address... CATCHMENT AREA

Owners Name... M.W.S. & D.B.
Address... CATCHMENT AREA

Access 17-10-1947
2 WID. ACCESS IN IDEAL CONDITIONS.
4 WID. MORE SUITABLE.
GATES AT PICNIC AREA MAY BE LOCKED.
M.W.S. & D.B. KEY REQUIRED.

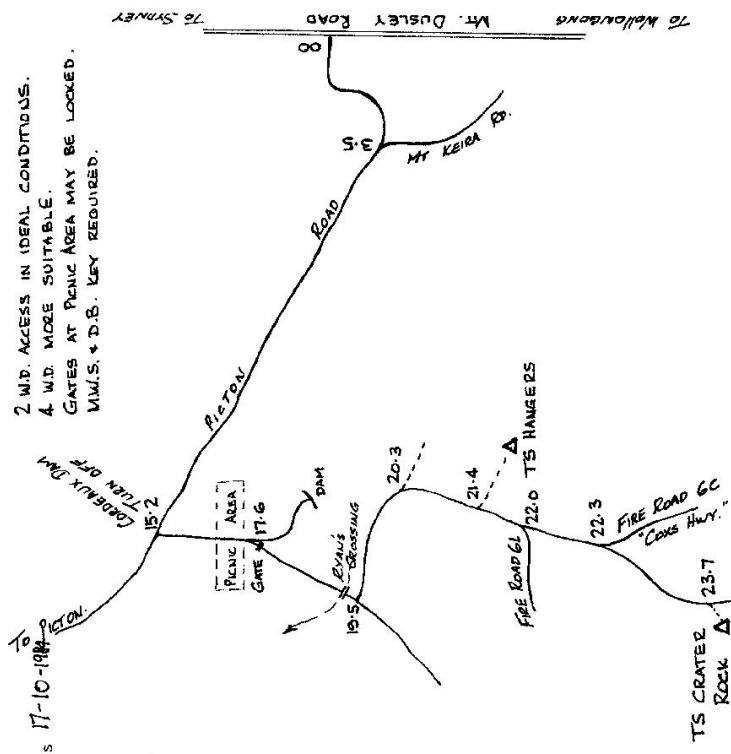

Station Diagram
Not to Scale

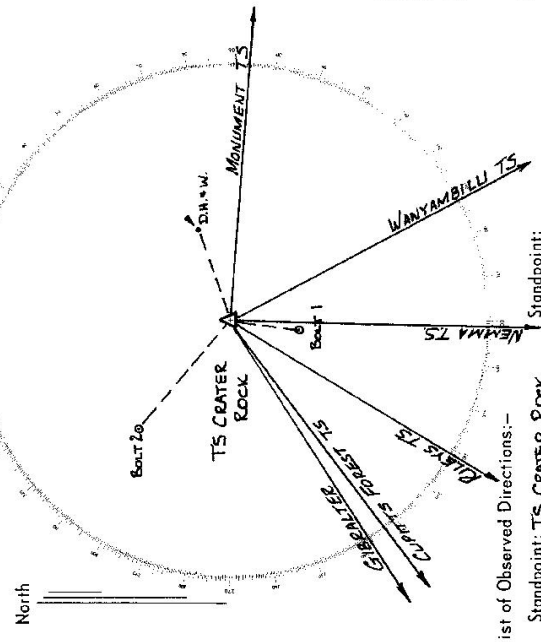

List of Observed Directions:-

Standpoint: TS CRATER ROCK

Station	Direction	Station	Direction
TS MONUMENT	0 00 00		
TS NEMMA	88 19 08		
BOLT 1	93 00 45		
TS CURTIS FOREST	139 48 46		
BOLT 2	205 46 07		
D.H. & W.	335 06 05		