

RECONNAISSANCE and MAINTENANCE REPORT

Department of Lands

This Trig. Station has been:-


Note: Cross out word or words which do not apply

- 1. Completely cleared to permit 360° vision to surrounding Trigs.
- 2. Cleared by lances bearing from Trig. Mast
- 3. Trig. Mast & Vanes have been painted white & black respectively.
- 4. The Trig. was unpiled/not unpiled, dimensions now being:
 - Description of mark **STEEL PILLAR, PVC MAST** should be explicit, e.g. Steel plug, Brass plug, Bolt, Concrete Pillar
 - Height of mark m above **STEEL PLATFORM** m above **G.L.**
 - Height of Top Vanes to **Top Mark/Top pillar plate** **1.46** m Diameter of Vanes (vertical) **0.160** m
 - Height of **Centre** **1.79** m. Diameter of **Centre** **0.125** m. **SAUSAGE**
 - Length of Mast **1.54** m. (approximate if not unpiled)
- 5. A set in conc./rock has been placed/fd m. bearing °M from Trig. Mast/pillar
- 6. A set in conc./soil has been placed/fd m. bearing °M from Trig. Mast/pillar
- 7. A set in conc./soil has been placed/fd m. bearing °M from Trig. Mast/pillar
- 8. A set in conc./rock has been placed/fd m. bearing °M from Trig. Mast/pillar
- 9. Connection to m. bearing °M
- 10. Connection to m. bearing °M
- 11. Connection to m. bearing °M
- 12. Connection to m. bearing °M
- 13. Diff. Ht. is m. ^{above}/_{below}
- 14. Diff. Ht. is m. ^{above}/_{below}
- 15. Diff. Ht. is m. ^{above}/_{below}
- 16. Diff. Ht. is m. ^{above}/_{below}

Prepared by: **L.G. TREVORROW** Checked: **A.S.P.**

STATION **NARAWALLEE (RES) TS 10830**
 Co: **ST. VINCENT** Ph: **ULLADULLA**
 Map Sheet: No:

Inspected by: **L.G. TREVORROW** Date: **25-5-84**
 Authority: **LANDS DEPARTMENT** Field Book: **5177**
 Not to Scale
PVC MAST

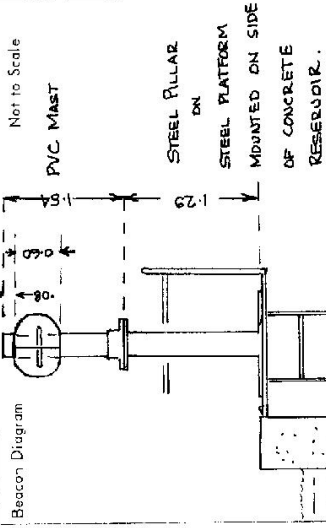

Date	Record of Station
25-5-84 Mast & Pillar removed to Council Depot.	


STATION TS 10830 (NARRAWALLEE)

Owners Name: SHANAHAN COUNCIL Current Occupant: RESERVOIR

Address: ULLADULLA

Access 25-5-1984

Station Diagram Not to Scale

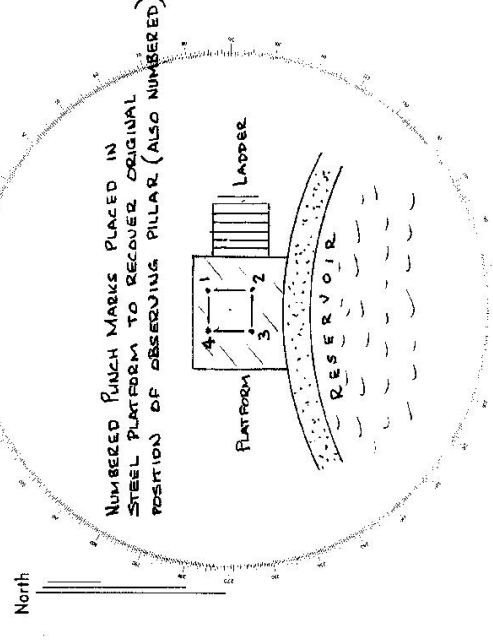

List of Observed Directions:-

Standpoint: TS NARRAWALLEE RES. Standpoint:

Station	Direction	Station	Direction
POGSON HOUSE	0 00 16		
LITTLE FOREST	33 08 47		
MILTON RES.	34 36 59		
ULLADULLA SOUTH RES.	264 34 11		
Station	Direction	Station	Direction

