

CENTRAL MAPPING AUTHORITY

Department of Lands

Trigonometrical Survey of N.S.W.

RECONNAISSANCE and MAINTENANCE REPORT

This Trig. Station has been:-

Note: Cross out word or words which do not apply

1. Completely cleared to permit 360° vision to surrounding Trigs.
2. Cleared by lanes bearing..... from Trig. Mast
3. Trig. Mast & Vanes have been painted ^{GREEN & YELLOW} ~~white & black~~ respectively.
4. The Trig. was unpiled/net unpiled, dimensions now being: NEW STATION
Description of mark..... STEEL PILLAR..... should be explicit, e.g. Steel plug, Brass plug, Bolt, G.I. Pipe
Height of mark..... m ^{above} ~~below~~ PLATFORM..... m ^{above} ~~below~~ G.L.
Height of Top Vanes to Top Mark 2.465 m. Diameter of Vanes (vertical) 0.60 m.

Height of Cairn..... m. Diameter of Cairn..... m.

Length of Mast..... m. (approximate if not unpiled)

5. A..... set in conc/rock has been placed..... m. bearing.....°M from Trig. Mast
6. A..... set in conc/soil has been placed..... m. bearing.....°M from Trig. Mast
7. A..... set in conc/soil has been placed..... m. bearing.....°M from Trig. Mast
8. A..... set in conc/rock has been placed..... m. bearing.....°M from Trig. Mast

9. Connection..... to..... :..... m. bearing.....°M

10. Connection..... to..... :..... m. bearing.....°M

11. Connection..... to..... :..... m. bearing.....°M

12. Connection..... to..... :..... m. bearing.....°M

13. Diff. Ht. is..... m. ^{above} ~~below~~

14. Diff. Ht. is..... m. ^{above} ~~below~~

15. Diff. Ht. is..... m. ^{above} ~~below~~

16. Diff. Ht. is..... m. ^{above} ~~below~~

Prepared by:

Checked:

Noted on U.T.M. Card

STATION NEPEAN RES. TS 10837


Co: CAMDEN Ph: BANKSIA

Map Sheet: No:

Inspected by: J. Potter Date: June 1984

Authority: M.W.S. & D.B. Field Book: LB 22259

Beacon Diagram Not to Scale

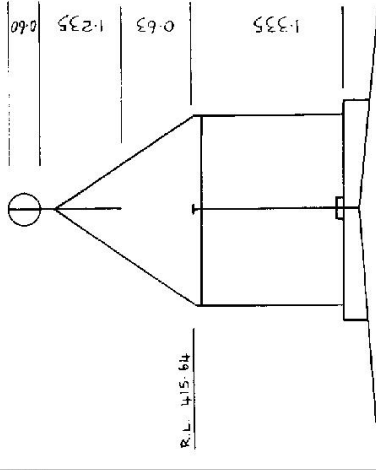

Date	Record of Station

Checked

STATION NEPEAN RE: TS 10837


TS 10837

Owners Name... M.W.S.F.D.B.
 Current Occupant... M.W.S.F.D.B.

Address.....
 Address.....


Access June 1984

Station Diagram
 Not to Scale

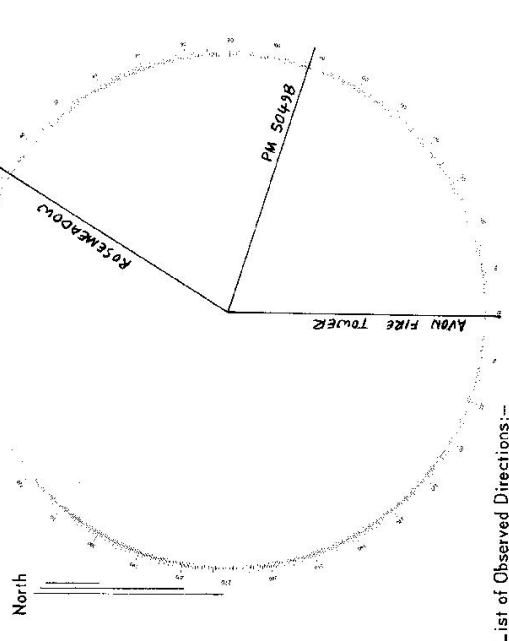

List of Observed Directions:-

Standpoint:		Station:	
Station	Direction	Station	Direction
AVON FIRE TOWER	0° 00' 00"		
TS 10837 ROSEMEADOW	21° 17' 00"		
PM 50498	288° 59' 45"		

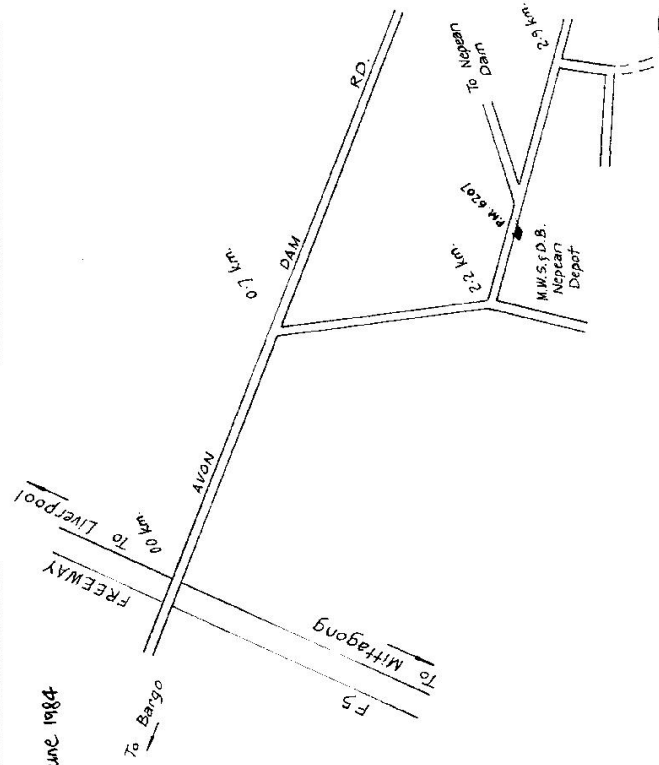

Key required for access to top of reservoir
 Origin of levels P.M. 6207 - R.L. 382.639

