

Trigonometrical Survey of N.S.W. 10840

RECONNAISSANCE and MAINTENANCE PORT

CENTRAL MAPPING AUTHORITY STATION DOMBARTC. (P) T.S.

Department of Lands Co: CAMDEN Ph: KEMBLA

This Trig. Station has been: Map Sheet: No: 9029-11-S

Note: Cross out word or words which do not apply Date: _____

1. ~~Completed~~ ~~cleared~~ ~~to~~ ~~permit~~ ~~260~~ ~~vision~~ ~~to~~ ~~surrounding~~ ~~Trig.~~ Field Book: _____

2. Cleared by lanes bearing as per Station Diagram from Trig. Mast

3. Trig. Mast & Vanes have been painted white & black respectively.

4. The Trig. was ~~erected~~ ~~erected~~ dimensions now being: Concrete Pillar should be explicit, e.g. Steel plug, Brass plug, Bolt, G.I. Pipe

Description of mark: Concrete Pillar Beacon Diagram

Height of mark: 1.37 m ^{above} ~~mark~~ / ~~concrete~~ 0-1 | Net to Scale

Height of Top Vanes to Top Mark: 1.48 m. 0-6

Height of ~~Cable~~ Cable 0-88

Length of Mast: _____ m. (approximate if not unipled) 1-37

5. A _____ set in conc/rock has been placed _____ m. bearing _____ °M from Trig. Mast

6. A _____ set in conc./soil has been placed _____ m. bearing _____ °M from Trig. Mast

7. A _____ set in conc./soil has been placed _____ m. bearing _____ °M from Trig. Mast

8. A _____ set in conc/rock has been placed _____ m. bearing _____ °M from Trig. Mast

9. Connection _____ to _____ m. bearing _____ °M

10. Connection _____ to _____ m. bearing _____ °M

11. Connection _____ to _____ m. bearing _____ °M

12. Connection _____ to _____ m. bearing _____ °M

13. Diff. Ht. _____ is _____ m. ^{above} ~~below~~

14. Diff. Ht. _____ is _____ m. ^{above} ~~below~~

15. Diff. Ht. _____ is _____ m. ^{above} ~~below~~

16. Diff. Ht. _____ is _____ m. ^{above} ~~below~~

Prepared by: B.H.P. Engineering Checked: _____ Noted on U.T.M. Card

Concrete Drainage Sump

Record of Station


3/84 Pillar erected by B.H.P. Engineering

Checked

10840 STATION **DOMBARTON (P) T.S.**

Owners Name: **State Rail Authority** Current Occupant: **S. R. A.**
 Address: **11 YORK ST SYDNEY 2000**
 SYDNEY 2000


Station Diagram

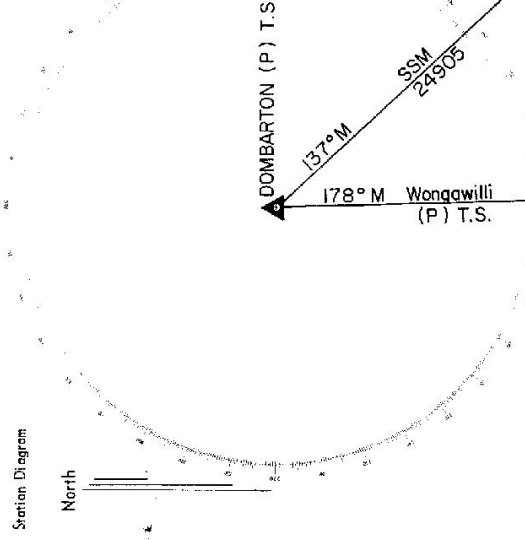

List of Observed Directions:-

Standpoint: PILLAR		Standpoint:	
Station	Direction	Station	Direction

Station	Direction	Station	Direction

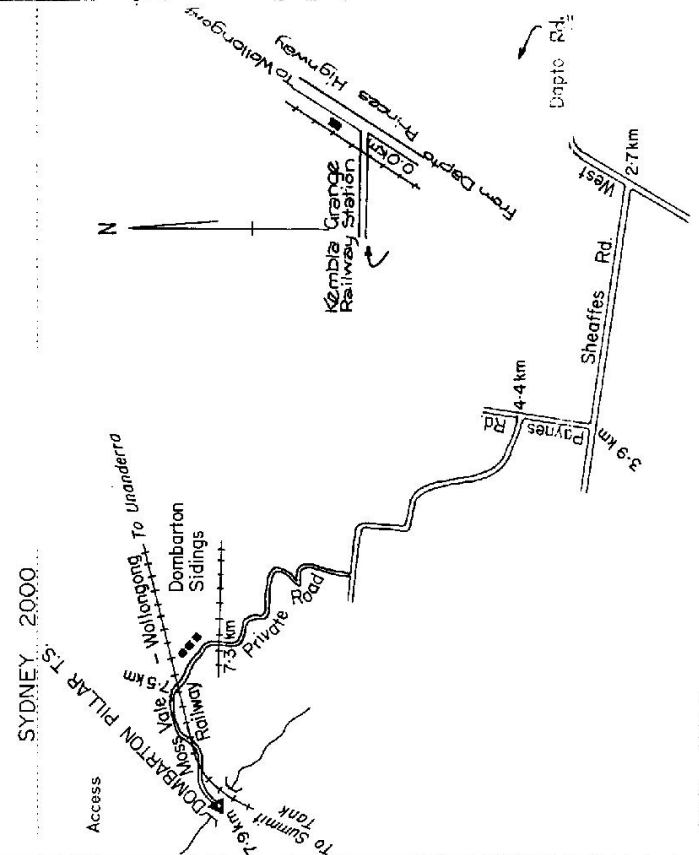

Scale **N.T.S.**