

CENTRAL MAPPING AUTHORITY  
Department of Lands

Trigonometrical Survey of N.S.W.  
10843  
RECONNAISSANCE and MAINTENANCE PORT

STATION WONGAWIL (P) T. S.

This Trig. Station has been:-

Note: Cross out word or words which do not apply

1. Completely cleared to permit 360° vision to surrounding Trigs.
2. ~~Cleared by tower-bearing~~ ..... from Trig. Mast
3. Trig. Mast & Vanes have been painted white & black respectively.
4. The Trig. was ~~replaced~~ dimensions now being: ~~Steel plug, Brass plug, Bolt, G.I. Pipe~~  
Description of mark Concrete Pillar ..... should be explicit, e.g. Steel plug, Brass plug, Bolt, G.I. Pipe  
Height of mark ..... m above ~~rock~~ concrete ..... m above G.L.  
Height of Top Vanes to Top Mark 1.48 m. Diameter of Vanes (vertical) 0.6 m.

5. A. Galv. Bolt set in conc./~~rock~~ has been placed. 19.65 m. bearing 263°M from Trig. Mast
6. A. Galv. Bolt set in conc./~~rock~~ has been placed. 19.98 m. bearing 173°M from Trig. Mast
7. A. set in conc./soil has been placed. .... m. bearing .....°M from Trig. Mast
8. A. set in conc./rock has been placed. .... m. bearing .....°M from Trig. Mast

9. Connection. .... to ..... m. bearing .....°M
10. Connection. .... to ..... m. bearing .....°M
11. Connection. .... to ..... m. bearing .....°M
12. Connection. .... to ..... m. bearing .....°M
13. Diff. Ht. .... is ..... m. above below
14. Diff. Ht. .... is ..... m. above below
15. Diff. Ht. .... is ..... m. above below
16. Diff. Ht. .... is ..... m. above below

Prepared by: B.H.P. ENGINEERING Checked: [Signature] Noted on U.T.M. Card

7-1-88

Co: CAMDEN      Ph: KEMBLA

Map Sheet: Wallongong      No: 9029-11-S

Inspected by:      Date:

Authority:      Field Book:

Beacon Diagram

Concrete

Earth

GL

Date: 3/84  
Record of Station  
Pillar erected by B.H.P. Engineering


Checked

10843 STATION WONGAWILLI (P) T.S. 10843

WOLLONGONG CITY COUNCIL  
Current Occupant: ROAD RESERVE


Address: BURELLI ST.  
WOLLONGONG

Access

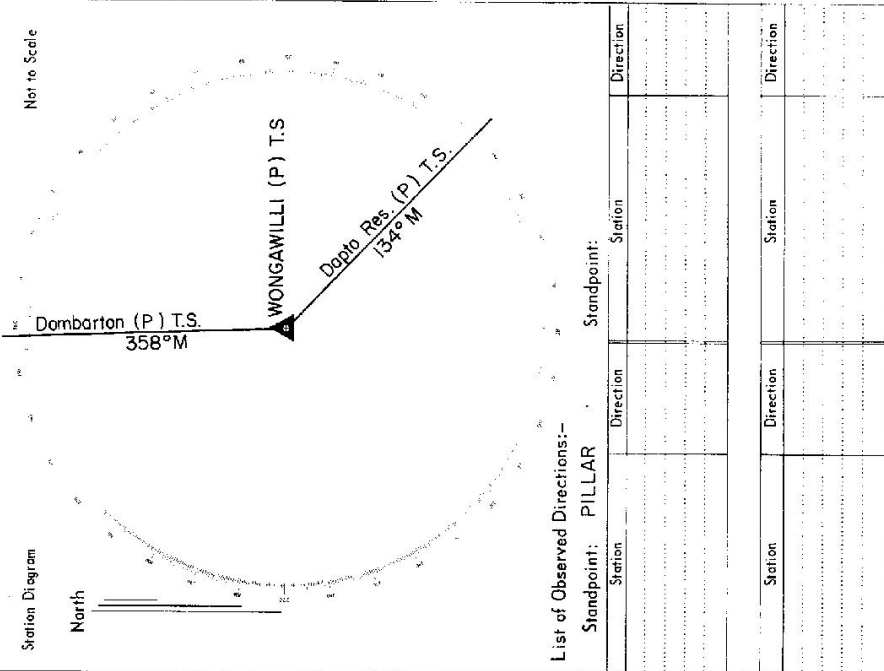

List of Observed Directions:-

Standpoint: PILLAR		Standpoint:	
Station	Direction	Station	Direction

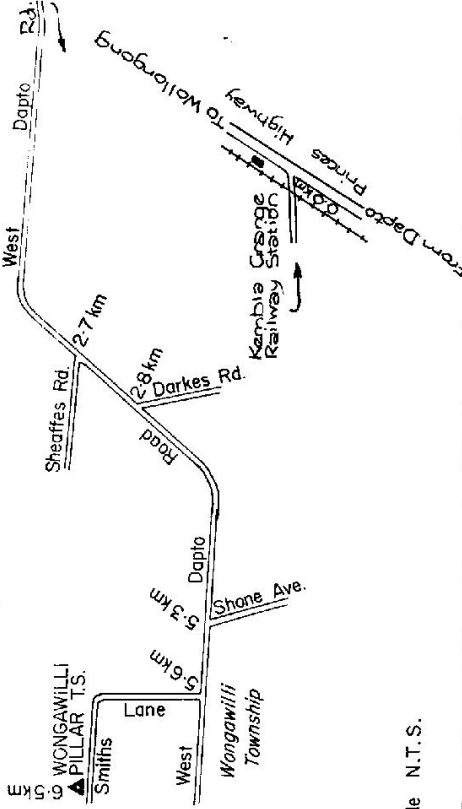

Scale N.T.S.

bt 2723-2 D. West. Government Printer

Beacon Diagram

Not to Scale


This section to be completed by officer constructing pillar.

Original station mark found/not found.

Description of mark: .....

Original beacon found/not found.

Description of beacon: .....

Height Top of Vanes to Top Mark.....m.

Height of mark.....m. above rock/conc.....m. above G.L.  
below below

Diameter of Vanes.....m.

Height of Cairn.....m.

Original Beacon has/has not been destroyed by me.

STATION WONGAWILLI (B) 10843

Owner's Name PILLAR IS NEXT

Address: TO ROAD ON THE ROAD RESERVE

Current Occupant:

Address:

Phone:

Phone:

ACCESS

Access Report of...../19.....was found suitable/unsuitable.

NEW ACCESS

0.00 FINISHES HWY x BONG BONG RD DAPTO HEAD WEST ALONG BONG BONG RD  
[MAIN CENTRE OF DAPTO]

0.3 CROSS RAILWAY LINE

2.4 LEFT FOLLOWING BONG BONG RD

2.6 RIGHT " " "

3.8 CROSS RAILWAY LINE AND TURN LEFT

4:2 RIGHT INTO SMITHS LANE

5.0 PILLAR ON RIGHT HAND SIDE OF ROAD.

Date

INSPECTED BY: G FORD DATE: 5-6-2000

Record of Station

Cleared by Janes bearing..... 360°..... from Trig. Mast  
Mast & Vanes have been painted white & black respectively. ✓