

7-108

RECONNAISSANCE and MAINTENANCE REPORT

Department of Lands

Integratic Survey of N.S.W.

This Trig. Station has been:-

Note: Cross out word or words which do not apply

- 1. Completely cleared to permit 360° vision to surrounding Trigs. ✓
- 2. ~~Cleared by fumes-bearing~~ from Trig. Mast
- 3. Trig. Mast & Vanes have been painted white & black respectively. ✓
- 4. The Trig. was unpiled/~~not-unpiled~~, dimensions now being: Concrete Pillar

Description of mark: Concrete Pillar should be explicit, e.g. Steel plug, Brass plug, Bol, Concrete Pillar

Height of mark: 1.61 m above rock/concrete 1.61 m above G.L.

Height of Top Vanes to Top Mast/Top pillar plate: 1.42 m Diameter of Vanes (vertical): 0.6 m.

Height of Cairn: 1.41 m. Diameter of Cairn: 0.33 - 0.55 m.

Length of Mast: 1.51 m. (approximate if not unpiled)

- 5. A. C.S. 1 set in conc/soil has been placed 4.17 m. bearing 277°M from Trig. Mast/pillar
- 6. A. G.P. 1 set in conc/soil has been placed 4.27 m. bearing 196°M from Trig. Mast/pillar
- 7. A. set in conc/soil has been placed fd m. bearing °M from Trig. Mast/pillar
- 8. A. set in conc/rock has been placed fd m. bearing °M from Trig. Mast/pillar

9. Connection C.S. 1 to G.P. 1 is 5.475 m. bearing 145.8°M

10. Connection to °M bearing °M

11. Connection to °M bearing °M

12. Connection to °M bearing °M

13. Diff. Ht. Pillar is 1.775 m. above G.P. 1

14. Diff. Ht. Pillar is 1.721 m. above C.S. 1

15. Diff. Ht. C.S. 1 is 0.058 m. above G.P. 1


16. Diff. Ht. is °M m. above °M

Prepared by: R. Duff

Checked: [Signature]

STATION TS 10846 UNITED [P]
 Co: LUNTER Ph: LEMINGTON
 Map Sheet: SINGLETON No: 9132 IV N
 Inspected by: A DUFFY Date: 8 Jan. 1985
 Authority: Survey Control NSW Field Book: 5360

Beacon Diagram Not to Scale

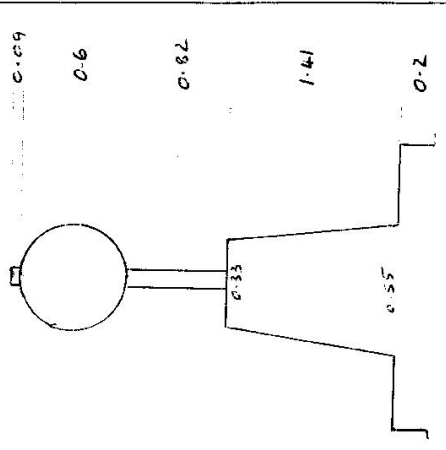

Date	Record of Station
<u>12/8/85</u>	<u>PILLAR ERRECTED</u>

