


STATION TS 10849 RIVAL JTN

Owners Name: ELECTRICITY COMM. Current Occupant: ELECTRICITY COMM.

Address:

Access 9-Jan-1985
 0.0 Km NEW ENGLAND HIGHWAY - " SINGLETON 19 / MUSWELLBROOK 27"
 take turn to "HEBBDEN" - 8km.
 0.2 Railway crossing
 0.6 Bridge
 1.2 Bridge
 3.6 Bridge
 5.25 Post Substation on left
 5.70 Hebbden Mining Company Offices on right Straight ahead.
 7.60 Turn left
 8.10 Causeway
 8.50 Bridge
 8.70 Double gates on right - take LH gate and follow southern fence in an easterly direction along track. keep fence on RHS.
 9.5 Turn left and follow track up gully
 10.1 TS RIVAL [P]

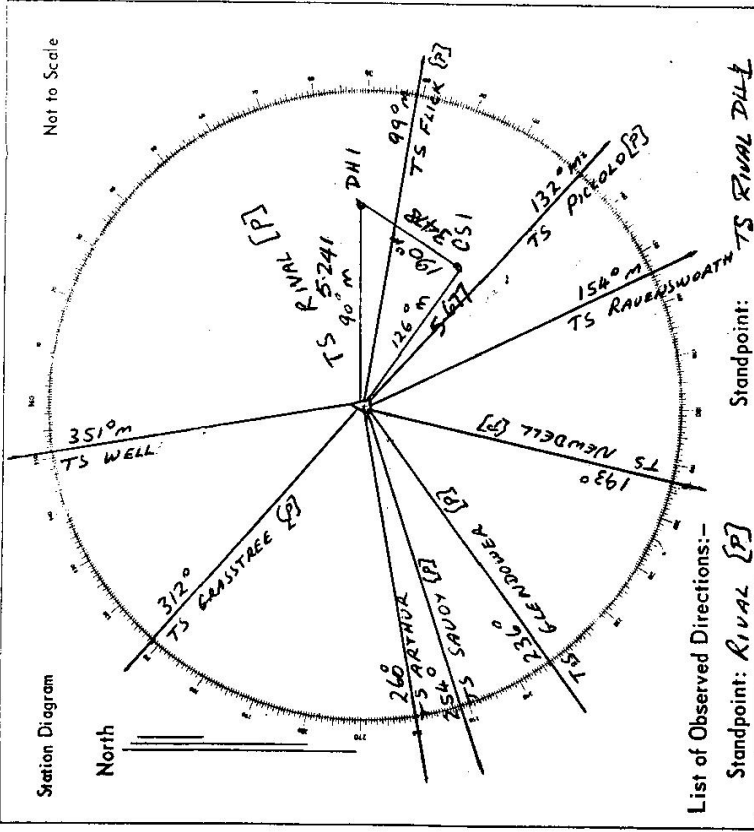

List of Observed Directions:-

Station	Direction	Station	Direction
TS ARTNOX (P)	0° 00' 00"	TS RIVAL (P)	0° 00' 00"
TS GRASSTREE (P)	42° 30' 45.4"	TS RIVAL (P)	28° 35' 36"
TS WELL	85° 45' 11.0"	TS RIVAL (P)	
TS RIVAL DILL	187° 08' 11"		
TS FLOCK (P)	196° 17' 17.0"		
TS RIVAL (P)	224° 00' 01"		
TS PICCOLO (P)	228° 28' 58.4"		
TS RAVENSWORTH (P)	257° 36' 55.2"		
TS NEWDELL (P)	280° 45' 40.8"		
TS GLENDAWER (P)	333° 24' 39.4"		
TS SAVOY (P)	351° 20' 27.4"		