

15 108

Department of Lands **RECONNAISSANCE and MAINTENANCE REPORT** **Integration Survey of N.S.W.**

STATION **TARANGLA** **TS 10850**  
 Co: **TUMBLESDOWN** Ph: **SOUTH DENILLOUN**  
 Map Sheet: **1:4000 DENILLOUN 9105 -9** No:  
 Inspected by: **R. LANDER** Date: **2-7-85**  
 Authority: **CROWN LANDS DEPT** Field Book:

Note: Cross out word or words which do not apply

This Trig. Station has been:-

1. Completely cleared to permit 360° vision to surrounding Trigs. ✓
2. Cleared by ~~lines bearing~~ from Trig-Mast
3. Trig. Mast & Vanes have been painted white & black respectively. ✓
4. The Trig. was unpiled/not unpiled, dimensions now being:

Description of mark: rock-concrete PLATEFORM should be explicit, e.g. Steel plug, Brass plug, Ball, Concrete Pillar

Height of mark: 1.34 m <sup>above</sup> ~~below~~ rock-concrete PLATEFORM m <sup>above</sup> ~~below~~ G.L.

Height of Top Vanes to ~~Top Mast~~/Top pillar plate: 1.43 m Diameter of Vanes (vertical) 0.59 m.

Height of Cairn: m. Diameter of Cairn: m.

Length of Mast: m. (approximate if not unpiled)


5. A. set in conc./rock has been placed/fd m. bearing °M from Trig. Mast/pillar
6. A. set in conc./soil has been placed/fd m. bearing °M from Trig. Mast/pillar
7. A. set in conc./soil has been placed/fd m. bearing °M from Trig. Mast/pillar
8. A. set in conc./rock has been placed/fd m. bearing °M from Trig. Mast/pillar

9. Connection: to: m. bearing: °M
10. Connection: to: m. bearing: °M
11. Connection: to: m. bearing: °M
12. Connection: to: m. bearing: °M

13. Diff. Ht. is m. <sup>above</sup> ~~below~~
14. Diff. Ht. is m. <sup>above</sup> ~~below~~
15. Diff. Ht. is m. <sup>above</sup> ~~below~~
16. Diff. Ht. is m. <sup>above</sup> ~~below~~

Prepared by: Robert R. ... 16-7-85 Checked:


Beacon Diagram Not to Scale

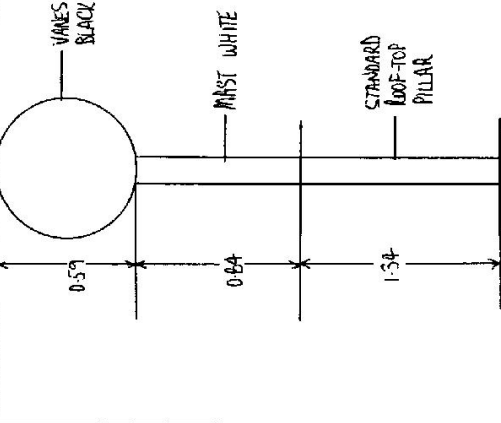

Date Record of Station

16-4-85 ERECTION PILLAR ON RESERVOIR BY ROAD  
 15-6-85 MAST & VANES ERECTED  
 15-6-85 MAST & VANES ATTACHED

<b>STATION</b>	<b>TERRANGLE TS 10850</b>	
Owners Name: DENILLOIN MUNICIPAL COUNCIL	Current Occupant:	
Address: END ST. DENILLOIN	Address:	
Ph (069) 812444		
Access 2-7-1985		
0.0 AT DENILLOIN POST OFFICE. HEAD SE ALONG CRESSY ST.		
0.45 TURN LEFT TOWARDS SHOOTGROUND & GOLF CLUB		
0.55 CROSS OVER BRIDGE		
0.9 AT TS ON RESERVOIR		

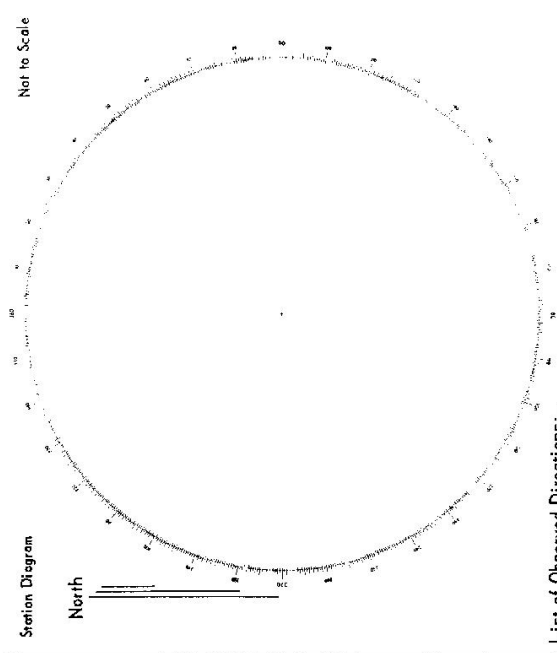

List of Observed Directions:-

Station		Standpoint:	
Station	Direction	Station	Direction