

GEODETIC SURVEY OF N.S.W.

CENTRAL MAPPING AUTHORITY

GEODETIC STATION RECONNAISSANCE and MAIN DIMENSION REPORT

Description: **Cleared by lanes bearing** *Note: Cross out word or words which do not apply*
 N/A *from Trig. Mast*

1. **Cleared by lanes bearing** *Note: Cross out word or words which do not apply*
 N/A *from Trig. Mast*
2. **Mast & Vanees have been painted white & black respectively.**
3. The station/pillar was unpiled/not unpiled/constructed on **N/A** 19....., dimensions now being:
 BASE OF **RED LIGHTS** should be explicit, e.g., S/Steel Pillar Plate, Steel plug, Brass plug, Bolt, G.I. Pipe
 Height of mark **RED LIGHTS**.....m. ^{above} rock/concrete; Mark is.....m. ^{above} G.L.
 Height of Top Vanees to Top Mark/Pillar plate.....m. Diameter of Vanees (vertical).....m.
 Height of Cairn.....m. Diameter of Cairn.....m. Name Plate found/not found/placed.
 Length of Mast.....m. (approximate if not supplied)
4. A..... set in conc/rock has been placed/found, bearing.....°M from Mast/Plug/Pillar
5. A..... set in conc/rock has been placed/found, bearing.....°M from Mast/Plug/Pillar
6. A..... set in conc/rock has been placed/found, bearing.....°M from Mast/Plug/Pillar
7. A..... set in conc/rock has been placed/found, bearing.....°M from Mast/Plug/Pillar
8. ACTION required.....

STANDPOINT:				STANDPOINT:			
Mark	Direction	Horiz. Distance	Height Difference	Mark	Direction	Horiz. Distance	Height Difference
			above standpt.				above standpt.
			below standpt.				below standpt.
			above standpt.				above standpt.
			below standpt.				below standpt.
Prepared by: **R. J. DUNNING** Checked: **S. POWIS** Noted on U.T.M. Card

St 2733-1

STATION: **MOORE FLOUR MILL RED LIGHT** No.: **10851**
 MAP SHEET: **1/4,000 ORTHOPHOTO/MAP SERIES**
 SCALE: **1:4000**
 INSPECTED BY: **R. J. DUNNING** DATE: **3/10/1984**
 AUTHORITY: **MORE LANDS OFFICE** FIELD BOOK:

Checked


STATION **FLOUR HILL RED LIGHT 10851**

Owner's Name:
 Address:
 Phone:

Current Occupant: **FLOUR MILL**
 Address: **CNR JONES AVE & GCSPORT**
STREE S. MOREE
 Phone:

Access Report of/19.....was found suitable/unsuitable.
ACCESS

NC ACCESS

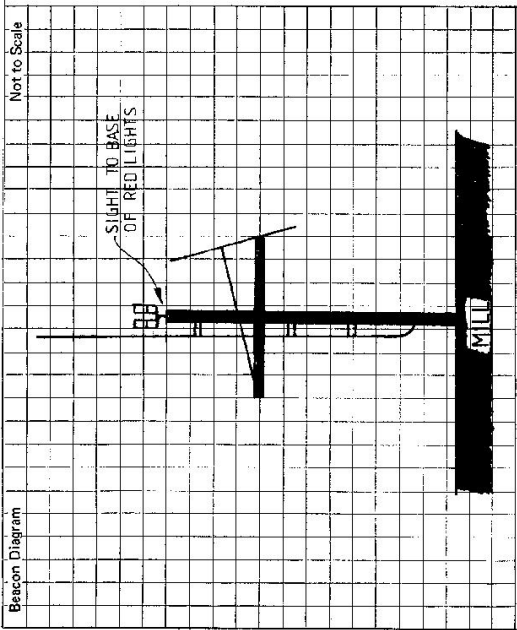

This section to be completed by officer constructing pillar.

Original station mark found/not found.

Description of mark: **BASE OF RED LIGHTS**

Original beacon found/not found.

Description of beacon:

Height Top of Vanes to Top Mark.....m.

Height of mark.....m. above rock/cont.....m. above G.L.
 below below

Diameter of Vanesm. Height of Galinm.

Original Beacon has/has not been destroyed by me.

Date	Record of Station