

CENTRAL MAPPING AUTHORITY

GEODETTIC SURVEY OF N.S.W.

GEODETTIC STATION RECONNAISSANCE and MAINTENANCE REPORT

Description:

1. Cleared by lanes bearing **N/A** *Note: Cross out word or words which do not apply from Trig. Mast*
2. Mast & Vane have been painted white & black respectively.
3. The station/pillar was unpiled/not unpiled/constructed on **N/A** 19....., dimensions now being:
BASE OF
Description of mark.....MAST.....should be explicit, e.g., S/Steel Pillar Plate, Steel plug, Brass plug, Bolt, G.I. Pipe
Height of mark.....m. ^{above} rock/concrete; Mark is.....m. ^{above} G.L.
^{below}
- Height of Top Vane to Top Mark/Pillar plate.....m. Diameter of Vane (vertical).....m.
Height of Cairn.....m. Diameter of Cairn.....m. Name Plate found/not found/placed.
- Length of Mast.....m. (approximate if not unpiled)
4. A.....set in conc/rock has been placed/found, bearing.....°M from Mast/Plug/Pillar
5. A.....set in conc/rock has been placed/found, bearing.....°M from Mast/Plug/Pillar
6. A.....set in conc/rock has been placed/found, bearing.....°M from Mast/Plug/Pillar
7. A.....set in conc/rock has been placed/found, bearing.....°M from Mast/Plug/Pillar
8. Action required.....

STANDPOINT:

Mark	Direction	Horiz. Distance	Height Difference	Mark	Direction	Horiz. Distance	Height Difference
			above standpt.				above standpt.
			below				below
			above standpt.				above standpt.
			below				below
Prepared by: R.J. DUNNING Checked: B. PDYS Noted on U.T.M. Card

S 2733-1


STATION: MOREE TELECOM TOWER	No.: 10853
MAP SHEET SCALE 1:4,000 ORTHOPHOTOGRAPH SERIES N 832-1	
INSPECTED BY: R.J. DUNNING	DATE: 4/10/84
AUTHORITY: MOREE LANDS OFFICE	
FIELD BOOK:	

Checked

St 2733-2 D. West, Government Printer

STATION

TELECOM WER TS 10853

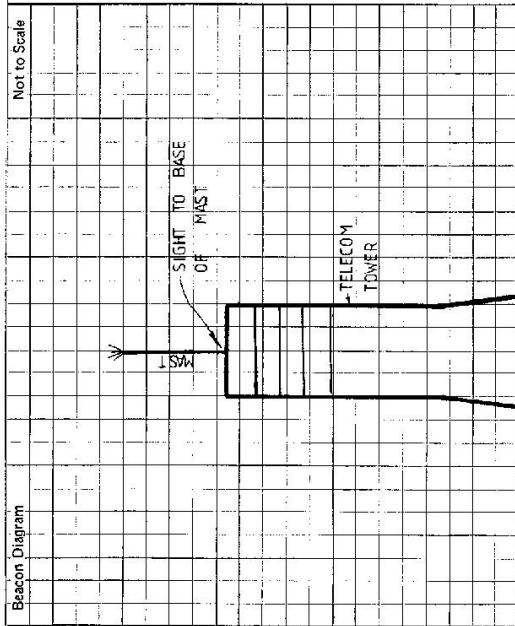

Owner's Name: TELECOM AUSTRALIA
 Address: C/- POST OFFICE
 FROM STREET MOREE
 Phone:

Current Occupant: "AS OWNER"
 Address:
 Phone:

ACCESS

Access Report of/19..... was found suitable/unsuitable.

NO ACCESS

This section to be completed by officer constructing pillar.

Original station mark found/not found.

Description of mark: BASE OF MAST

Original beacon found/not found.

Description of beacon:

Height Top of Vanes to Top Markm.

Height of markm. above G.L. below

Diameter of Vanesm. Height of Cairnm.

Original Beacon has/has not been destroyed by me.

Date

Record of Station