

GEODETIC SURVEY OF N.S.W.

CENTRAL MAPPING AUTHORITY

GEODETIC STATION RECONNAISSANCE and MAINTENANCE REPORT

Description:

1. Cleared by lanes bearing..... **N/A**.....
Note: Cross out word or words which do not apply
 from Trig. Mast
2. Mast & Vanes have been painted white & black respectively.
3. The station/pillar was unpiled/not unpiled/constructed on..... **N/A**.....
 dimensions now being:
 BASE OF
 Description of mark. **RED LIGHT**..... should be explicit, e.g., S/Steel Pillar Plate, Steel plug, Brass plug, Bolt, G.I. Pipe
 Height of mark.....m. above rock/concrete; Mark is.....m. above below G.L.
 Height of Top Vanes to Top Mark/Pillar-plate.....m. Diameter of Vanes (vertical).....m.
 Height of Cairn.....m. Diameter of Cairn.....m. Name Plate found/not found/plateed.
 Length of Mast.....m. (approximate if not unpiled)
4. ~~A..... set in conc/rock has been placed/found, bearing.....° M from Mast/Plug/Pillar~~
5. ~~A..... set in conc/rock has been placed/found, bearing.....° M from Mast/Plug/Pillar~~
6. ~~A..... set in conc/rock has been placed/found, bearing.....° M from Mast/Plug/Pillar~~
7. ~~A..... set in conc/rock has been placed/found, bearing.....° M from Mast/Plug/Pillar~~
8. Action required:.....

STANDPOINT:

Mark	Direction	Horiz. Distance	Height Difference	Mark	Direction	Horiz. Distance	Height Difference
			above standpt.				above standpt.
			below				below
			above standpt.				above standpt.
			below				below
Prepared by: R. J. DUNNING

Checked: B. P. M.S.

Noted on U.T.M. Card

SI 2733-1

TS MOREE SILC DUTH No.: 10854

STATION: MAP SHEET 1/50,000 TOPOGRAPHIC MAP SERIES SCALE 1:50,000 **MOREE 8850 - II & III**


INSPECTED BY: R. J. DUNNING DATE: 3-10-64

AUTHORITY: MOREE LANDS OFFICE FIELD BOOK:

Checked

St 2733-2 D. West, Government Printer

STATION **TS MOREE SOUTH TS 10854**

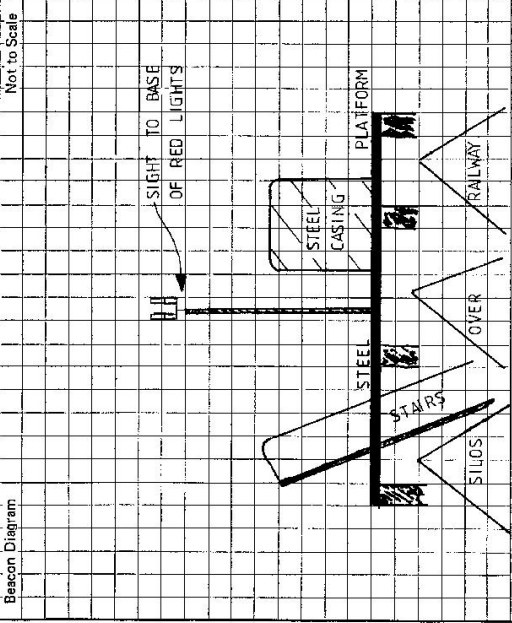

Owner's Name: G.H.A. OF N.S.W.
 Address: INDUSTRIAL DRIVE
 MOREE 2400
 Phone: 321110

Current Occupant: AS OWNER
 Address:
 Phone:

Access Report of 3/10/84 was found suitable/unsuitable.
ACCESS
 ACCESS - CONTACT GRAIN HANDLING AUTHORITY (G.H.A) OF N.S.W.
 ACCESS VIA STEEL LADDERS.

This section to be completed by officer constructing pillar.

Original station mark found/not found.
 Description of mark: **BASE OF RED LIGHTS**
 Original beacon found/not found.
 Description of beacon:
 Height Top of Vanes to Top Mark m.
 Height of mark: m. above G.L. below
 Diameter of Vanes m. Height of Cairn m.
 Original Beacon has/has not been destroyed by me.

Date	Record of Station