

CENTRAL MAPPING AUTHORITY
Department of Lands

Trigonometrical Survey of N.S.W.

RECONNAISSANCE and MAINTENANCE REPORT

This Trig. Station has been:-

Note: Cross out word or words which do not apply

1. Completely cleared to permit 360° vision to surrounding Trigs.
2. Cleared by lances bearing..... from Trig. Mast
3. Trig. Mast & Vanes have been painted ~~white~~ & black respectively.
4. The Trig. was unpiled/not unpiled, dimensions now being: NEW STATION

Description of mark: STEEL PLATE should be explicit, e.g. Steel plug, Brass plug, Bolt, G.I. Pipe
 Height of mark: 1.20 m above rock/concrete PLATE m above G.L.
 Height of Top Vanes to Top Mark: 1.41 m. Diameter of Vanes (vertical): 0.6 m.

Height of Centre: m. Diameter of Centre: m.
 Length of Mast: m. (approximate if not upright)

5. A..... set in conc/rock has been placed..... m. bearing.....°M from Trig. Mast
6. A..... set in conc/soil has been placed..... m. bearing.....°M from Trig. Mast
7. A..... set in conc/soil has been placed..... m. bearing.....°M from Trig. Mast
8. A..... set in conc/rock has been placed..... m. bearing.....°M from Trig. Mast

9. Connection..... to..... m. bearing.....°M
10. Connection..... to..... m. bearing.....°M
11. Connection..... to..... m. bearing.....°M
12. Connection..... to..... m. bearing.....°M

13. Diff. Ht. TOP OF PLATE is 3.100 m. above PLATE 3.100 m. above PLATE


14. Diff. Ht. is..... m. ^{above}/_{below}
15. Diff. Ht. is..... m. ^{above}/_{below}
16. Diff. Ht. is..... m. ^{above}/_{below}

Prepared by: Checked:

Noted on U.T.M. Card

STATION TS 10856
 Co: CUMBERLAND Ph: NOELTON

Map Sheet: No: 117382
 Inspected by: D. Hobb Date: 9-7-85
 Authority: M.C.S.F. 0.2 Field Book: RE 6620

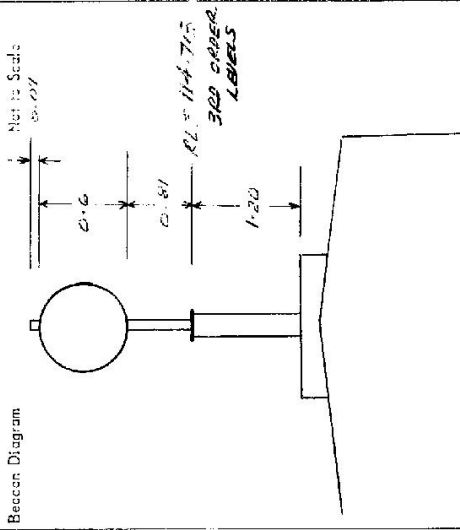

Date	Record of Station

Checked

STATION 6205 DIA (P) TS 10856

Current Occupant M.W.S. E.D.B.

Owners Name M.W.S. E.D.B.


Address

Address

9-7-85
 Access SEE UBD MAP 116 K2
 KEY REQUIRED FOR ACCESS TO RESERVOIR SITE.
 SEE PL B.22174 FOL 50-51 FOR DETAILS OF LEVINGS


BM 43952 BM 1 But in concrete block
 83.653

STEEL PULAR ON
 TOP OF ELEVATED
 RESERVOIR

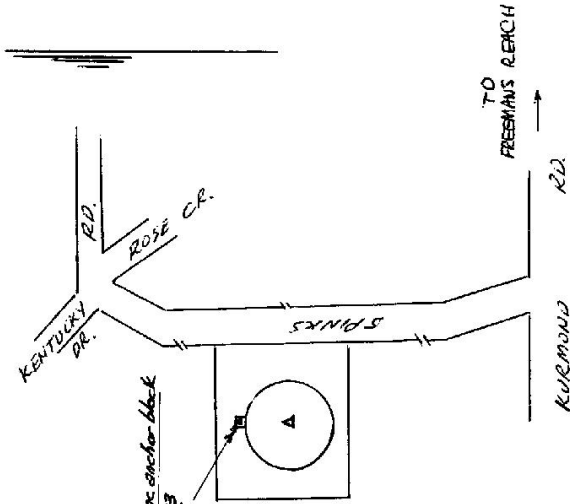

Not to Scale

Station Diagram

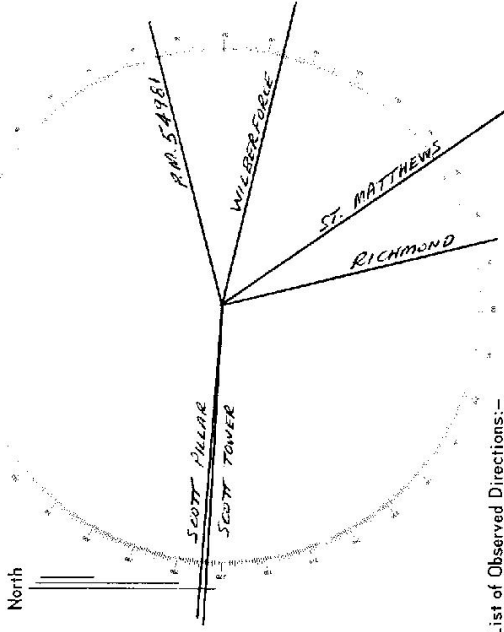

List of Observed Directions:-

Standpoint:		Standpoint:	
Station	Direction	Station	Direction
RICHMOND	8° 00' 00"	ST. MATTHEWS	329° 34' 52"
SCOTT TOWER	107° 26' 46"		
SCOTT PULVAR	07° 20' 45"		
M.D. 54981	268° 01' 44"		
WILBERFORCE	297° 11' 24"		
Station	Direction	Station	Direction