



STATION TS 10860 (VENTURE (P))

Owners Name: VICKERY JOINT VENTURE Current Occupant: Owner


Address: GUNNEDAT Address

Access From Gunnedah P.O. May 1985

- 0.0. Traveled west along Conardilly St
- 0.6 Turn Right into Chardas St
- 1.2 Bridge
- 2.3 Turn Left (Blue Vale Rd)
- 8.4 Caution
- 9.3 "
- 25.1 Turn Left
- 27.2 straight ahead.
- 28.8 Past Mine entrance on RHS.
- 30.1 Turn right through Locked Gate: Key from Mine

Follow track up hill to TS.

30.4 TRIG.

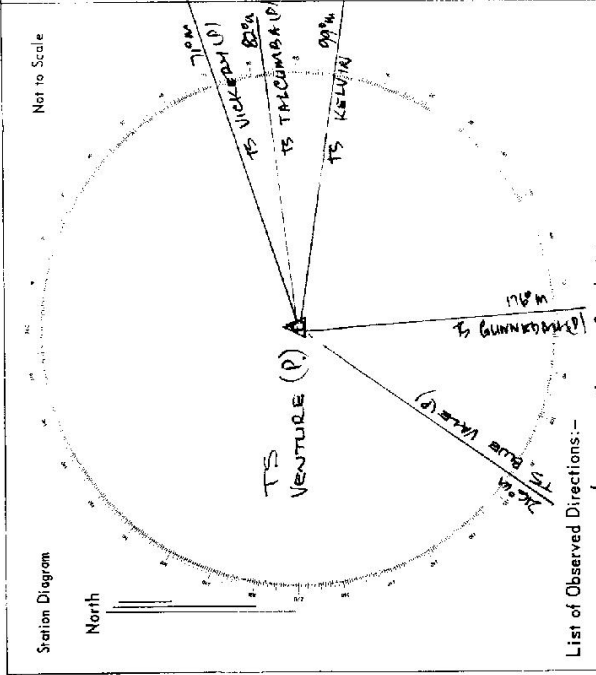

List of Observed Directions:-

Station	Direction	Station	Direction
TS VICKERY (P)	71° 29' 11"	TS GUNNEDAT (P)	170° 00'
TS TRILCOMBA (P)	82° 40' 05"	TS BLUE VALE (P)	216° 22' 40"
TS KELVIN	99° 49' 21"		
TS GUNNEDAT (P)	176° 55' 07"		
TS BLUE VALE (P)	216° 22' 40"		