


10861  
 STATION **TS BOREHOLE [P]**  
 Ph. WALLA WALLA WEST Co POTTINGER  
 MAP BORAH 1:50000  
 No: 8836-S  
 Inspected by: **A. DUFFY**  
 Date: 22.7.85  
 Authority **SCB N.C.L.E**  
 Field Book: 5372/19

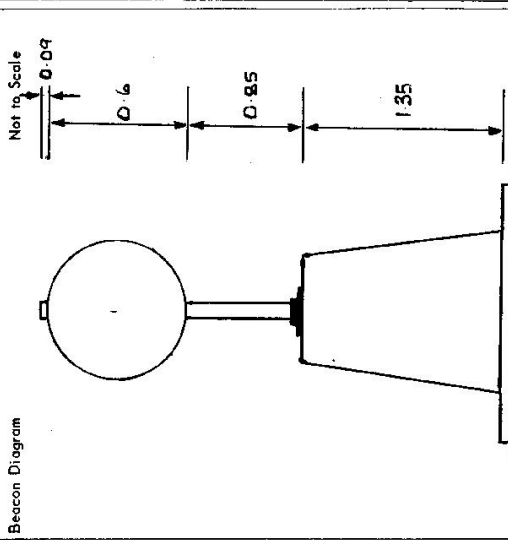

Beacon Diagram

Date	1-7-85
Record of Station	RECORDED

Department of Lands  
 Integrative Survey of N.S.W.  
 RECONNAISSANCE and MAINTENANCE REPORT

This Trig. Station has been: completely cleared to permit 360° vision to surrounding Trigs.  
 Note: Cross out word or words which do not apply

1. Completely cleared to permit 360° vision to surrounding Trigs.  
 2. Cleared by lanes-bearing  
 3. Trig. Mast & Vanes have been painted white & black respectively.  
 4. The Trig. was supplied/mast supplied, dimensions now being:

Description of mark... CONCRETE PILLAR should be explicit, e.g. Steel plug, Brass plug, Bolt, Concrete Pillar  
 Height of mark... 1.35 m <sup>above</sup> rock/concrete <sub>below</sub> G.L.  
 Height of Top Vanes to Top pillar plate 1.45 m Diameter of Vanes (vertical) 0.6 m.  
 Height of Pillar 1.35 m. Diameter of Top 33 x 55 m.  
 Length of Mast 1.54 m. (approximate if not unipled)

5. A set in conc/rock has been placed/d m-bearing 0M from Trig-Mast/pillar  
 6. A set in conc/soil has been placed/d m-bearing 0M from Trig-Mast/pillar  
 7. A set in conc/soil has been placed/d m-bearing 0M from Trig-Mast/pillar  
 8. A set in conc/rock has been placed/d m-bearing 0M from Trig-Mast/pillar

9. Connection to 0M bearing 0M  
 10. Connection to 0M bearing 0M  
 11. Connection to 0M bearing 0M  
 12. Connection to 0M bearing 0M

13. Diff. Ht. is 0M above below  
 14. Diff. Ht. is 0M above below  
 15. Diff. Ht. is 0M above below  
 16. Diff. Ht. is 0M above below

Prepared by: AD Checked: AD


STATION TS 10861 FOREHOLE (P)

Owners Name... FAIRFIELD DIST. CO Current Occupant... OWNED /


Address... FAIRFIELD Address.....

Via BOGGABRA 22-7-1985

Access VIA "FAIRFIELD"

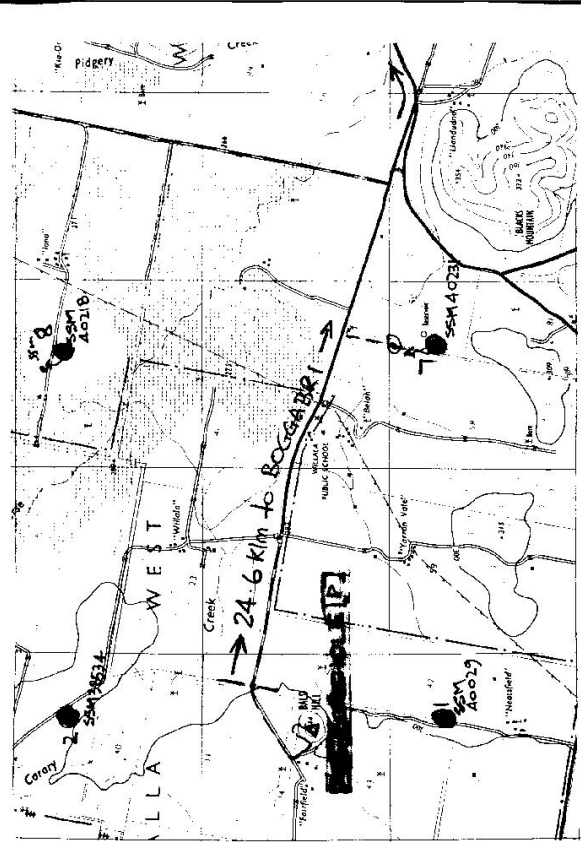

FROM "BORAH" 1:50,000  
D. West, Government Printer, New South Wales - 1976

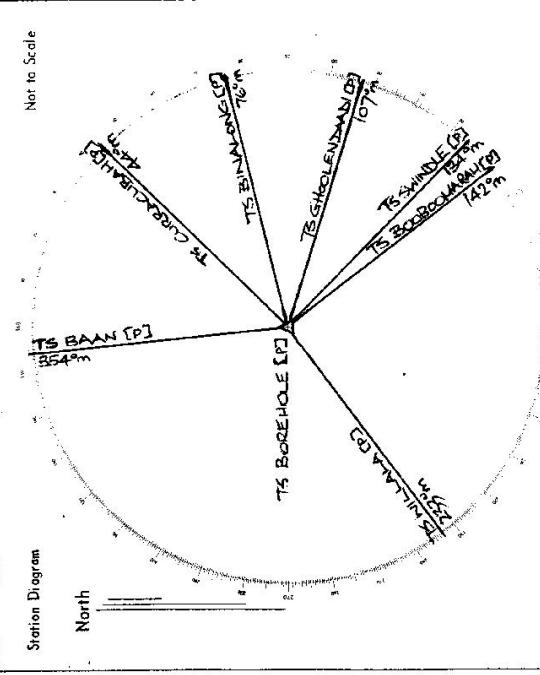

List of Observed Directions:-

Standpoint: TS BOREHOLE (P) Standpoint:

Station	Direction	Station	Direction
TS WILLALA (P)	295° 00' 00"		
TS BAAN (P)	354° 00' 00"		
TS CURRAGUBAH (P)	44° 30' 30"		
TS SHINDLE (P)	76° 15' 57"		
TS SHOLENDABDI (P)	107° 41' 24"		
TS SHINDLE (P)	135° 30' 43"		
TS BOOROMARAH (P)	141° 58' 58"		