

7-8-88

CENTRAL MAPPING AUTHORITY
Department of Lands


Trigonometrical Survey of N.S.W.
RECONNAISSANCE or MAINTENANCE REPORT

TS 10866

STATION *CRAWNER & RES (P)*
 Co: *CUMBERLAND* Ph: *CASTLERAGH*
 Map Sheet: _____ No: _____
 Inspected by: *R McL* Date: *7-85*
 Authority: *M. W. S. & P. B.* Field Book: *A2620*

This Trig. Station has been: _____
 Note: Cross out word or words which do not apply

1. Completely cleared to permit 360° vision to surrounding Trigs.
2. Cleared by lanes bearing..... from Trig. Mast
3. Trig. Mast & Vanes have been painted ~~white~~ & black respectively.
4. The Trig. was unpiled/not unpiled, dimensions now being: ~~Station Mast form~~ **NEW STATION**
 Description of mark..... ~~STEEL PLATE~~ **BATTERY** should be explicit, e.g. Steel plug, Brass plug, Bolt, G.I. Pipe
 Height of mark..... ~~1.15~~ **1.45** m above ~~rock/concrete~~ **concrete** G.L. below
 Height of Top Vanes to Top Mark **1.45** m. Diameter of Vanes (vertical) **0.5** m.
 Height of Cut-in..... m. Diameter of Cap..... m.
 Length of Mast..... m. (approximate if not unpiled)
5. A..... set in conc/rock has been placed..... m. bearing.....°M from Trig. Mast
6. A..... set in conc/soil has been placed..... m. bearing.....°M from Trig. Mast
7. A..... set in conc/soil has been placed..... m. bearing.....°M from Trig. Mast
8. A..... set in conc/rock has been placed..... m. bearing.....°M from Trig. Mast
9. Connection..... to..... m. bearing.....°M
10. Connection..... to..... m. bearing.....°M
11. Connection..... to..... m. bearing.....°M
12. Connection..... to..... m. bearing.....°M
13. Diff. Ht. ~~TOP OF PLATE~~ **TOP OF BATTERY** ~~is~~ **is** ~~above~~ **below** ~~BM1~~ **BM1**
14. Diff. Ht. is..... m. ~~above~~ **below**
15. Diff. Ht. is..... m. ~~above~~ **below**
16. Diff. Ht. is..... m. ~~above~~ **below**

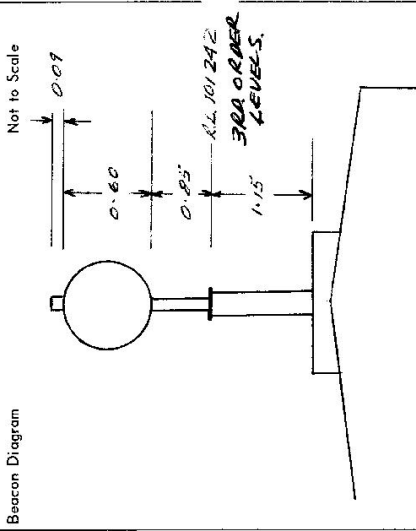

Date	Record of Station

Checked

Noted on U.T.M. Card

Prepared by: _____


STATION *CRANEBO* RES (P)

T-10866

Owners Name... *M.M.S. S.R.R.* Current Occupant... *M.M.S. S.R.R.*

Address.....

7-1985
 Access SEE UGD MAP 328 K 4
 KEY REQUIRED FOR ACCESS TO PILLAR ON TOP OF RESERVOIR
 SEE P.L.B 22174 FOL. 45:52 FOR LEVELLING DETAILS

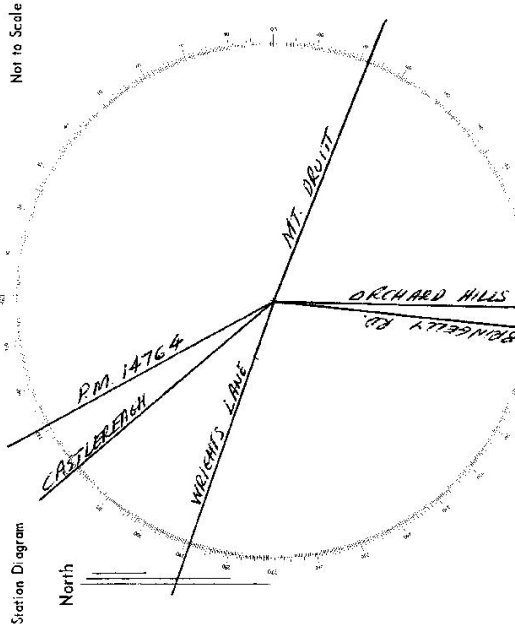

List of Observed Directions:-

Standpoint:		Standpoint:	
Station	Direction	Station	Direction
<i>BRANGELY RD</i>	<i>0° 00' 00"</i>	<i>ORCHARD HILLS</i>	<i>333° 37' 16"</i>
<i>WILCH'S LAKE</i>	<i>102° 30' 17"</i>		
<i>CASTLEBENCH</i>	<i>133° 31' 00"</i>		
<i>RM 14764</i>	<i>144° 37' 52"</i>		
<i>MT. DRUIT</i>	<i>205° 35' 16"</i>		

