

LAND INFORMATION CENTRE

GEODETIC SURVEY OF N.S.W.

GEODETIC STATION RECONNAISSANCE and MAINTENANCE REPORT

Description:

1. Cleared by lanes bearing..... from Trig. Mast ✓
Note: Cross out word or words which do not apply
 2. Mast & Vanes have been painted white & black respectively.
Station was established by Moree Lanes Office.
 3. The station/pillar was unpiled/not unpiled/constructed on.....
Galvanised steel
- Description of mark..Pillar..Plate.. should be explicit, e.g., S/Steel Pillar Plate, Steel plug, Brass plug, Bolt, G.I. Pipe
- Height of mark.....m. ^{above} ~~below~~ *Steel Platform* Mark is.....m. ^{above} ~~below~~ *G.L.*
- Height of Top Vanes to Top ~~Plate~~/Pillar plate 1.210.....m. Diameter of Vanes (vertical).....m. *0.585*
- Height of Cairn.....m. Diameter of Cairn.....m. Name Plate ~~found~~/not found/~~found~~
- Length of Mast.....m. (approximate if not unpiled)
4. A..... set in conc/rock has been placed/found, bearing.....°M from Mast/Plug/Pillar
 5. A..... set in conc/rock has been placed/found, bearing.....°M from Mast/Plug/Pillar
 6. A..... set in conc/rock has been placed/found, bearing.....°M from Mast/Plug/Pillar
 7. A..... set in conc/rock has been placed/found, bearing.....°M from Mast/Plug/Pillar
8. Action required:.....

STANDPOINT:

Mark	Direction	Horiz. Distance	Height Difference	Mark	Direction	Horiz. Distance	Height Difference
			above standpt				above standpt
			below				below
			above standpt				above standpt
			below				below
Prepared by: **D. Kain**

Checked:

Noted on U.T.M. Card

Checked

STATION: **Moree** ~~Lea Gully~~ ~~Ch-B-Ros(P)~~ No.: **15 1086A**

MAP SHEET SCALE 1:250 000

INSPECTED BY: **D. J. Kain** DATE: **25.3.91.**

AUTHORITY: **L.I.C.** FIELD BOOK: **Coos II**

Station Diagram

Not to Scale

Moree
STATION LEAGUES TS-10869

Owner's Name: Moree Plains Shire Council
 Address: Frame Street, Moree
 Phone:

ACCESS

Access Report of 25/3/1991 was found suitable/unsuitable.

Access To Leagues Club Res. R/T (P) FEATURE.


Kms.

- 0.00 At Moree Post Office, Travel South Along Frame Street.
- 0.19 Turn Right into ALBERT Street.
- 0.33 Turn Left into Ballo Street, (Newell Highway)
- 0.86 Cross Rans Bridge over MEHI RIVER.
- 1.56 Turn Right into Adelaide Street.
- 2.88 At steel water Reservoir, Station on North Western side of Reservoir.

KEY IS REQUIRED FOR COMPOUND AND LADDER ACCESS
 Contact:- MR. GRSHAME BAUGHTON.
 Water and Sewerage Services
 Moree Shire Council
 Frame Street Moree Phone (067) 529534

DR:- LANDS OFFICE, FRAME STREET MOREE.

2735-2 D. West, Government Printer

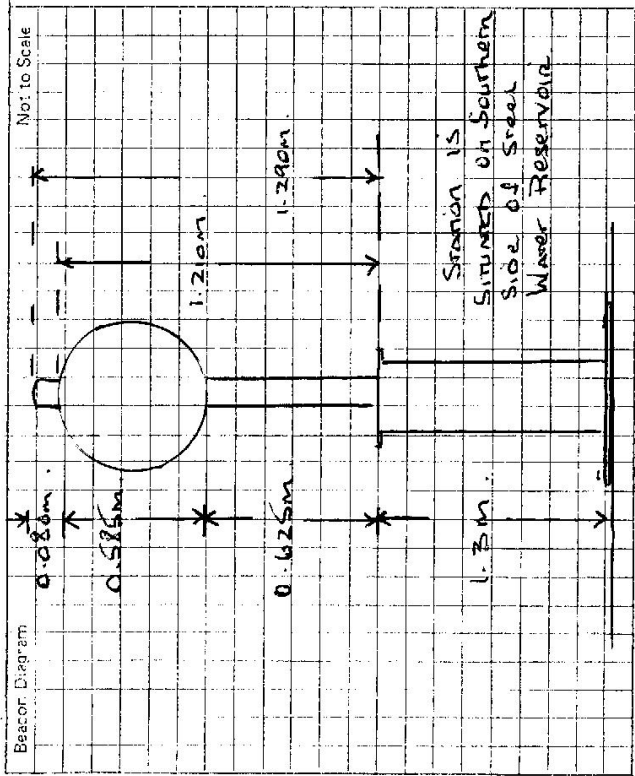

This section to be completed by officer constructing pillar.

Original station mark found/not found:

Description of mark:

Original beacon found/not: found.

Description of beacon:

Height: Top of Vanes to Top Mark.....m.

Height of mark.....m. above rock/conic.....m. above G.L. below

Diameter of Vanesm. Height of Cairn.....m.

Original Beacon has/has not been destroyed by me.

Date	Record of Station

LAND INFORMATION CENTRE

GEODETIC SURVEY OF N.S.W.

GEODETIC STATION RECONNAISSANCE and MAINTENANCE REPORT

Description:

1. Cleared by Janes bearing..... *Note: Cross out word or words which do not apply*
2. Mast & Vanes have been painted white & black respectively. from Trig. Mast
3. The station/pillar was unpiled/not unpiled/constructed on..... 19.....; dimensions now being: Description of mark..... should be explicit, e.g., S/Steel Pillar Plate, Steel plug, Brass plug, Bolt, G.I. Pipe
- Height of mark.....^{above} m. rock/concrete; Mark is.....^{above} m. G.L. ^{below}
- Height of Top Vanes to Top Mark/Pillar plate m. Diameter of Vanes (vertical)..... m.
- Height of Cairn..... m. Diameter of Cairn..... m. Name Plate found/not found/placed.
- Length of Mast m. (approximate if not unpiled)
4. A..... set in conc/rock has been placed/found, bearing..... °M from Mast/Plug/Pillar
5. A..... set in conc/rock has been placed/found, bearing..... °M from Mast/Plug/Pillar
6. A..... set in conc/rock has been placed/found, bearing..... °M from Mast/Plug/Pillar
7. A..... set in conc/rock has been placed/found, bearing..... °M from Mast/Plug/Pillar
8. Action required:.....

STATION: **Moree League (P)** No: **TS10869**

MAP SHEET SCALE 1:250 000

INSPECTED BY: **D. Kain** DATE: **31.7.95**

AUTHORITY: **L.I.C.** FIELD BOOK: **---**

330 340 350 360 10 20 30

Station Diagram North

Not to Scale

320 310 300 290 280 270 260 250 240 230 220

140 130 120 110 100 90 80 70 60 50 40

210 200 190 180 170 160 150

Note: ~

NEW MAST AND VANES MEASUREMENTS ONLY.

MAST / VANES AND SAFETY WIRE WERE PLACED BY MOREE PLAINS SHIRE COUNCIL 7.7.1995

STANDPOINT:				STANDPOINT:			
Mark	Direction	Horiz. Distance	Height Difference	Mark	Direction	Horiz. Distance	Height Difference
			above standpt. below				above standpt. below
			above standpt. below				above standpt. below
Prepared by: **D. Kain** Checked: **---** *Noted on U.T.M. Card*

TS 10269

STATION **Moree League (P)**

Owner's Name: **Moree Plains Shire Council**

Address: **Bado Street
Moree**

Phone:

Current Occupant:


Address:

Phone:

ACCESS

Access Report of/19..... was found suitable/unsuitable.

St: 2733-2 D. West, Government Printer

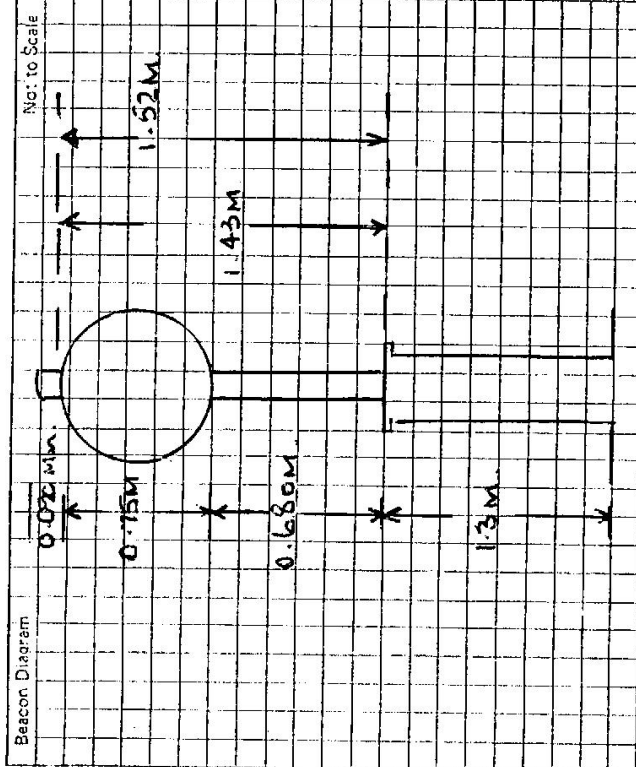

This section to be completed by officer constructing pillar.

Original station mark found/not found.

Description of mark:

Original beacon found/not found.

Description of beacon:

Height Top of Vanes to Top Markm.

Height of markm. above rock/conc.m. above G.L.
below

Diameter of Vanesm. Height of Cairnm.

Original Beacon has/has not been destroyed by me.

Date	Record of Station
.....
.....
.....